


0
1
2
3

Longitude 80 25

Harriet L. Whiteman
31^a

S.T. Flanagan
41 ³/₄ ^a

0.4 Mi. ± South to Hannah School

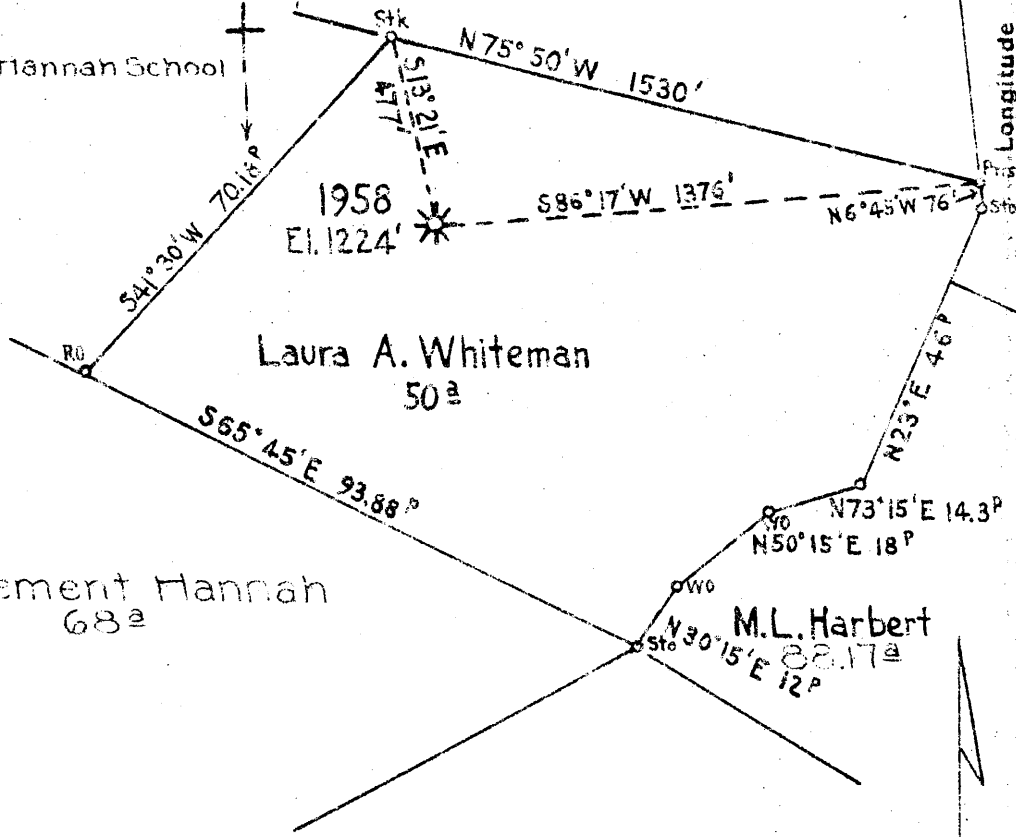

Nelson Hannah
113 ²/₃ ^a

2.63 S
3.99 W

New Location
Drill Deeper
Abandonment **x1958**

Map 45 Squares S6E7 FB 543 P20

Company	HOPE NATURAL GAS CO.	
Address	CLARKSBURG, W. VA.	
Farm	LAURA A. WHITEMAN	
Tract	Acres 50	Lease No. 21497
Well (Farm) No.	Serial No. 1958	
Elevation (Spirit Level)	1224	
Quadrangle	CLARKSBURG	
County	HARRISON	District SARDIS
Engineer	<i>W.M. Bowers</i>	
Engineer's Registration No.	900	
File No.	Drawing No.	
Date	SEPT. 19, 1946	Scale 1" = 30 P

STATE OF WEST VIRGINIA
DEPARTMENT OF MINES
OIL AND GAS DIVISION
CHARLESTON

WELL LOCATION MAP
FILE NO HAR-1012-A

+ Denotes location of well on United States Topographic Maps, scale 1 to 62,500, latitude and longitude lines being represented by border lines as shown.

- Denotes one inch spaces on border line of original tracing.



STATE OF WEST VIRGINIA
DEPARTMENT OF MINES
OIL AND GAS DIVISION

856

1012-A

WELL RECORD

Oil or Gas Well (KIND)

Permit No. 1012-A

Company Hope Natural Gas Company,
Address 445 West Main St. Clarksburg, W. Va.
Farm Laura A. Whiteman Acres 50
Location (waters) _____
Well No. 1958 Elev. 1224
District Sardis County Harrison
The surface of tract is owned in fee by _____
Address _____
Mineral rights are owned by _____
Address _____
Drilling commenced October 14, 1910
Drilling completed December 3, 1910
Date Shot _____ From _____ To _____
With _____
Open Flow _____ /10ths Water in _____ Inch
_____ /10ths Merc. in _____ Inch
Volume _____ Cu. Ft.
Rock Pressure _____ lbs. _____ hrs.
Oil _____ bbls., 1st 24 hrs.
Fresh water 1265 1590 feet feet
Salt water _____ feet feet

Casing and Tubing	Used in Drilling	Left in Well	Packers
Size			
16			Kind of Packer
13			
10	322	322	Size of
8 1/4	1408	1408	
6 3/4	2158	2158	Depth set
5 3/16	2324	2324	
3			Perf. top
2	2843	2843	Perf. bottom
Liners Used			Perf. top
			Perf. bottom

NOT CASING CEMENTED SIZE No. Ft. Date

COAL WAS ENCOUNTERED AT 295 FEET 60 INCHES
845 FEET 60 INCHES FEET INCHES
FEET INCHES FEET INCHES

Formation	Color	Hard or Soft	Top	Bottom	Oil, Gas or Water	Depth Found	Remarks
✓ Native coal			295	300			
Pittsburgh Coal			845	850			
Little Dunkard			1245	1300	water	1265	
Big Dunkard			1410	1429			
Gas sand			1515	1620	water	1590	
First Salt			1635	1660			
Second Salt			1760	1842			
Maxon			1957	2019			
Little Lime			2032	2091			
Pencil cave			2091	2102			
Big Lime			2102	2140			
Big Injun			2140	2247			
Fifty foot			2716	2740			
Thirty foot			2827		gas	2827	
Total depth				2843			

Formation	Color	Hard or Soft	Top	Bottom	Oil, Gas or Water	Depth Found	Remarks

Date September 19, 1946., 19

APPROVED Hope Natural Gas Company., Owner

By [Signature] General Superintendent.
(Title)

