

D. E. Hurst
62a

J. W. Kyle
24a

O. M. Kyle
70a


Wm Hurst
6046a

T. Hurst
70a

S. Gerrard Lot

0.70S
0.54W

KATY LICK

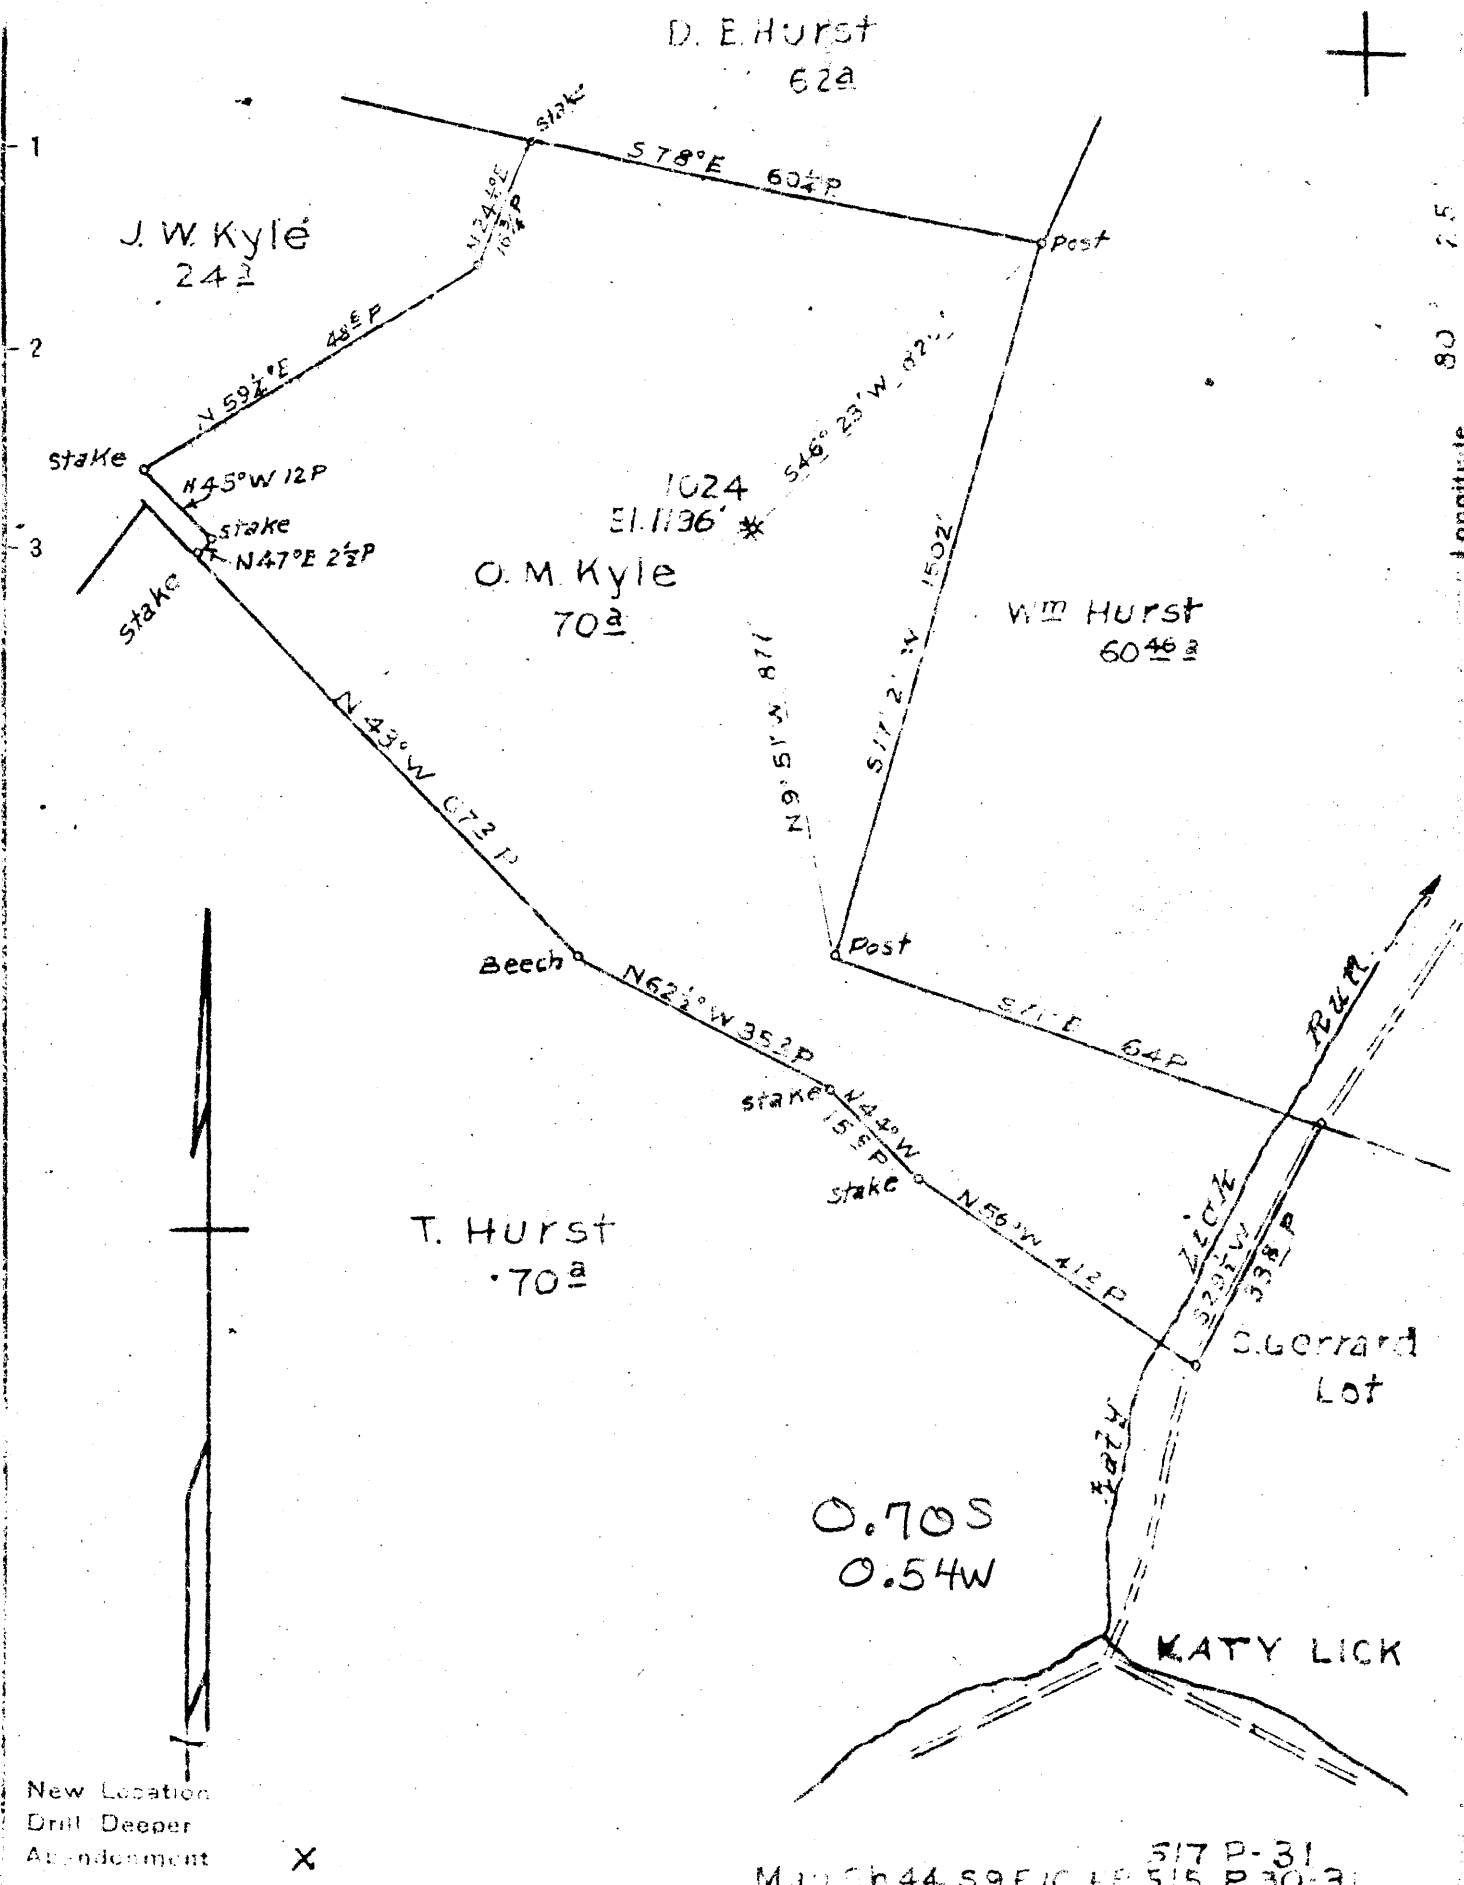

New Location
Drill Deeper
Abandonment X

517 P-31
M 10 Ch 44 S 9 E 10 E 515 P 30-31

Company Hope Natural Gas Co
 Address Clarksburg, W. Va.
 Farm O. M. Kyle
 Tract _____ Acres 70 Lease No. 2269
 Well (Farm) No. _____ Serial No. 1024
 Elevation (Spirit Level) 1136'
 Quadrangle Clarksburg
 County Harrison District Sardis
 Engineer W. M. Bewers
 Engineer's Registration No. 900
 File No. _____ Drawing No. _____
 Date 9-9-46 Scale 1" = 400'

STATE OF WEST VIRGINIA
 DEPARTMENT OF MINES
 OIL AND GAS DIVISION
 CHARLESTON

WELL LOCATION MAP
 FILE NO. HARR-1031-A

+ Denotes location of well on United States Topographic Maps, scale 1 to 62,500, latitude and longitude lines being represented by border lines as shown.

- Denotes one inch spaces on border line of original tracing



861

STATE OF WEST VIRGINIA
DEPARTMENT OF MINES
OIL AND GAS DIVISION

WELL RECORD

Oil or Gas Well _____
(KIND)

Permit No. 1031-A

Company Hope Natural Gas Company.

Address 445 West Main St. Clarksburg, W. Va.

Farm O.M. Kyle Acres 70

Location (waters) _____

Well No. 1024 Elev. 1196

District Sardis County Harrison

The surface of tract is owned in fee by _____
Address _____

Mineral rights are owned by _____
Address _____

Drilling commenced February 1, 1908

Drilling completed April 1, 1908

Date Shot _____ From _____ To _____

With _____

Open Flow _____ /10ths Water in _____ Inch
_____ /10ths Merc. in _____ Inch

Volume _____ Cu. Ft.

Rock Pressure _____ lbs. _____ hrs.

Oil _____ bbls., 1st 24 hrs.

Fresh water 525 feet _____ feet

Salt water none feet _____ feet

Casing and Tubing	Used in Drilling	Left in Well	Packers
Size			Kind of Packer _____
16			
13			
10	628	Pulled	Size of _____
8 1/4	1498	1498	
6 5/8	1600	Pulled	Depth set _____
5 3/16	2285	156	
3			Perf. top _____
2	1705	1705	Perf. bottom _____
Liners Used			Perf. top _____
			Perf. bottom _____

CASING CEMENTED **NOT** SIZE _____ No. Ft. _____ Date _____

COAL WAS ENCOUNTERED AT **60** FEET **48** INCHES
_____ FEET _____ INCHES _____ FEET _____ INCHES
_____ FEET _____ INCHES _____ FEET _____ INCHES

Formation	Color	Hard or Soft	Top	Bottom	Oil, Gas or Water	Depth Found	Remarks
Pittsburgh Coal			60	64			
Little Dunkard			470	528	water	525	
Big Dunkard			570	624			
Gas sand			628	700			
First Salt			707	800			
Second Salt			910	1140			
Maxon			1374	1403	gas	1381	
Little Lime			1418	1430			
Pencil cave			1430	1438			
Big Lime			1450	1515			
Big Injun			1515	1622	gas	1532	
Fifty foot			2023	2085			
Thirty Foot			2135	2155			
Gordon stray			2270	2293	gas	2280	
Gordon			2299	2334			
Fourth			2345	2360			
Fifth			2471	2483	gas	2473	
Total depth				2487			
Filled back to				1705			

Formation	Color	Hard or Soft	Top	Bottom	Oil, Gas or Water	Depth Found	Remarks

Date **September 11, 1946**, 19

APPROVED **Hope Natural Gas Company.**, Owner

By **General Superintendent.** (Title)

