

H. J. Garrett
28a


M. P. Thompson
18a

T. P. Reynolds
5E 215a

Brown - Smith
50a

Mary R. Shinn
21 1/4a

7958
E11107

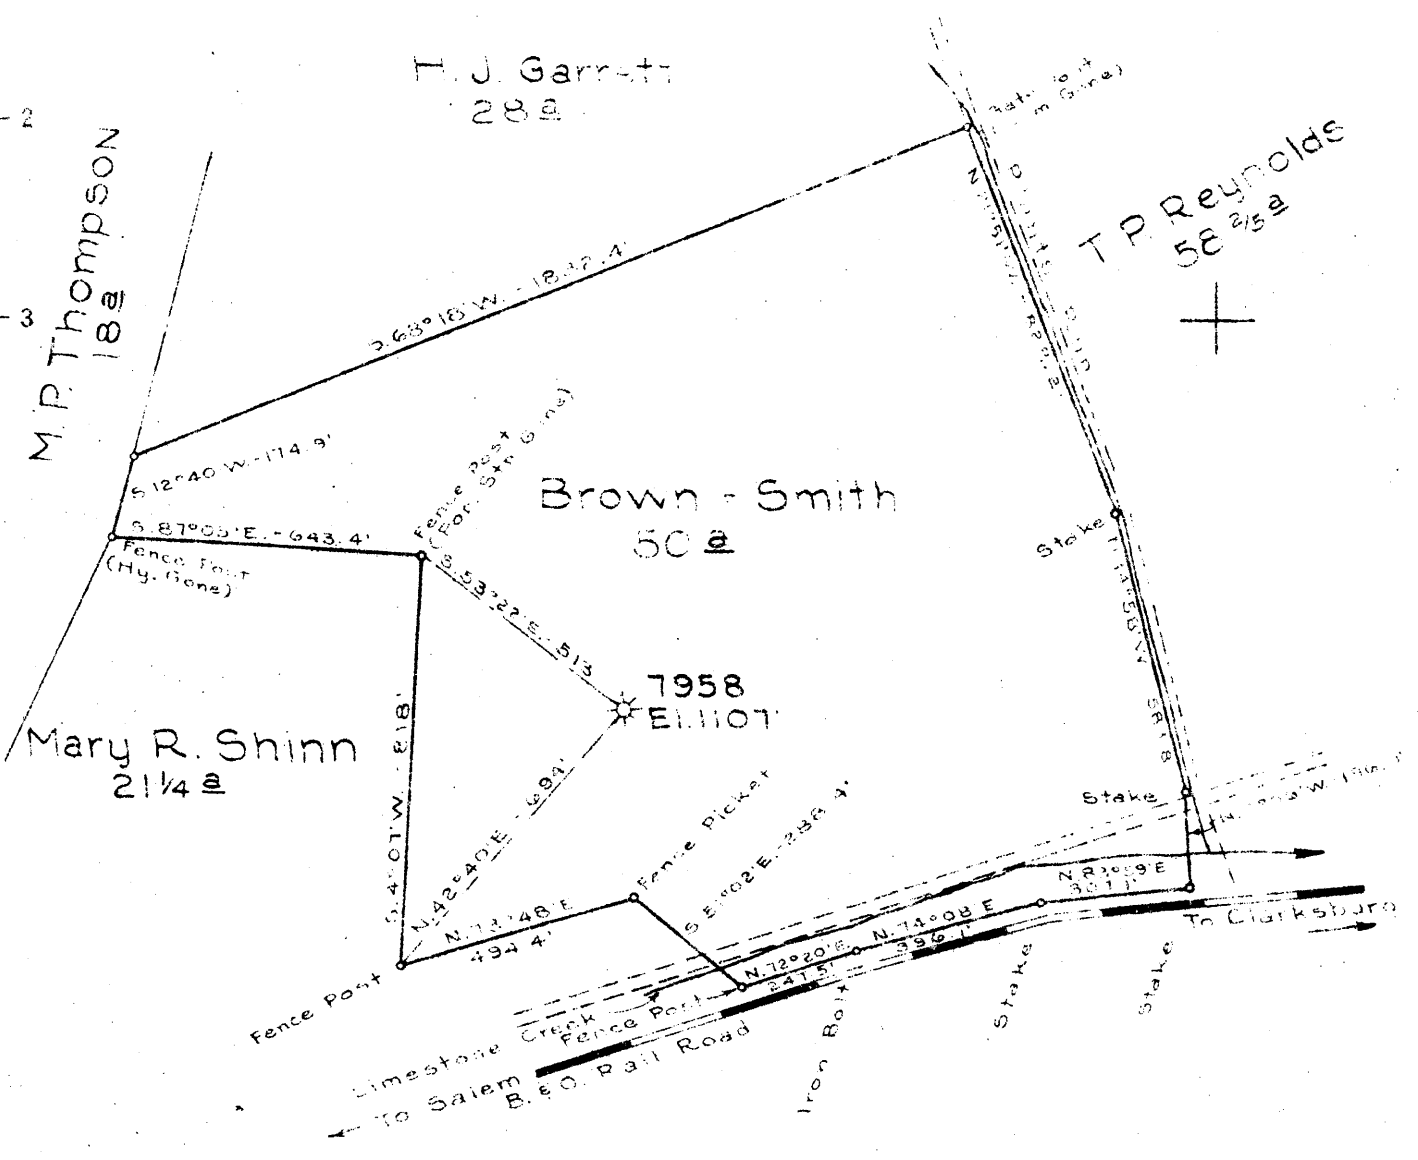

3.22S
1.28W

New Location
Drill Deeper
Abandonment X

Map Sheet #44 Sq. 6.12 E.10 FB 835 R2C

Company Hope Natural Gas Co.
 Address Clarksburg, W. Va.
 Farm Brown - Smith
 Tract _____ Acres 50 Lease No. 52698
 Well Farm No. _____ Serial No. 7958
 Elevation (Spirit Level) 1107'
 Quadrangle Clarksburg
 County Harrison District Coal
 Engineer W. M. Powers
 Engineer's Registration No. 900
 File No. _____ Drawing No. _____
 Date Dec 10, 1946 Scale 1" = 400'

STATE OF WEST VIRGINIA
DEPARTMENT OF MINES
OIL AND GAS DIVISION
CHARLESTON

WELL LOCATION MAP
FILE NO. HAR-1036-A

+ Denotes location of well on United States
Topographic Maps, scale 1 to 62,500. Lat-
itude and longitude lines being represented
by border lines as shown.

- Denotes one inch spaces on border line
of original tracing.

Longitude 80 25