


John Hamond
62 $\frac{3}{4}$ a



Longitude 80° 20'

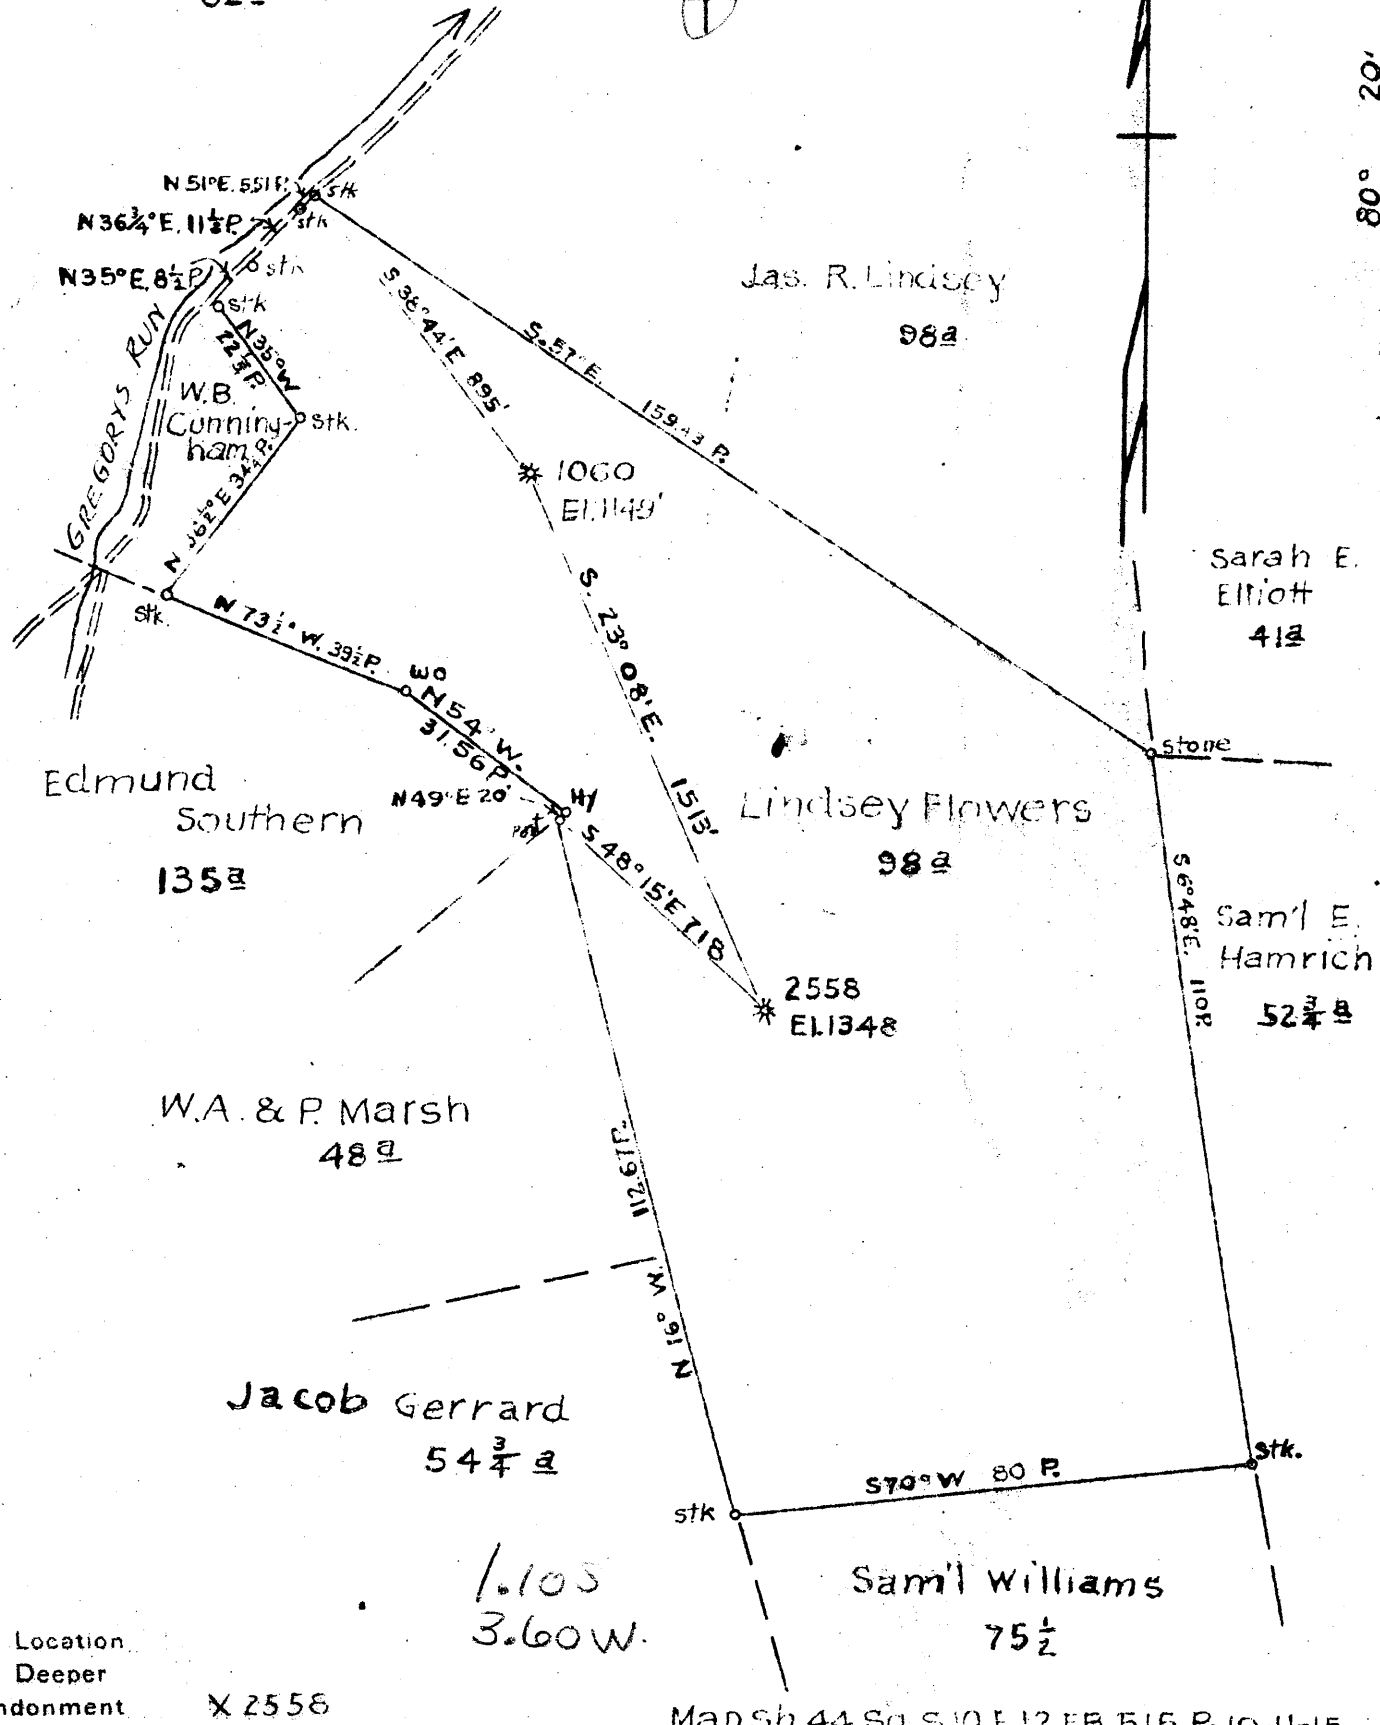

New Location
Drill Deeper
Abandonment X 2558

1.105
3.60 W.

Map Sh. 44 Sq. S10 E12 FB. 515 P-10-11-15

Company Hope Natural Gas Co.
 Address Clarksburg W. Va.
 Farm Lindsey Flowers
 Tract _____ Acres 98 Lease No. 4194 &c
 Well (Farm) No. _____ Serial No. As Shown
 Elevation (Spirit Level) As Shown
 Quadrangle Clarksburg
 County Harrison District Sardis
 Engineer W.M. Bowers
 Engineer's Registration No. 900
 File No. _____ Drawing No. _____
 Date 3-4-47 Scale 1" = 500'

STATE OF WEST VIRGINIA
 DEPARTMENT OF MINES
 OIL AND GAS DIVISION
 CHARLESTON

WELL LOCATION MAP
 FILE NO. HAR-1052-A

+ Denotes location of well on United States Topographic Maps, scale 1 to 62,500, latitude and longitude lines being represented by border lines as shown.

- Denotes one inch spaces on border line of original tracing