


0
1
2
3

105
03

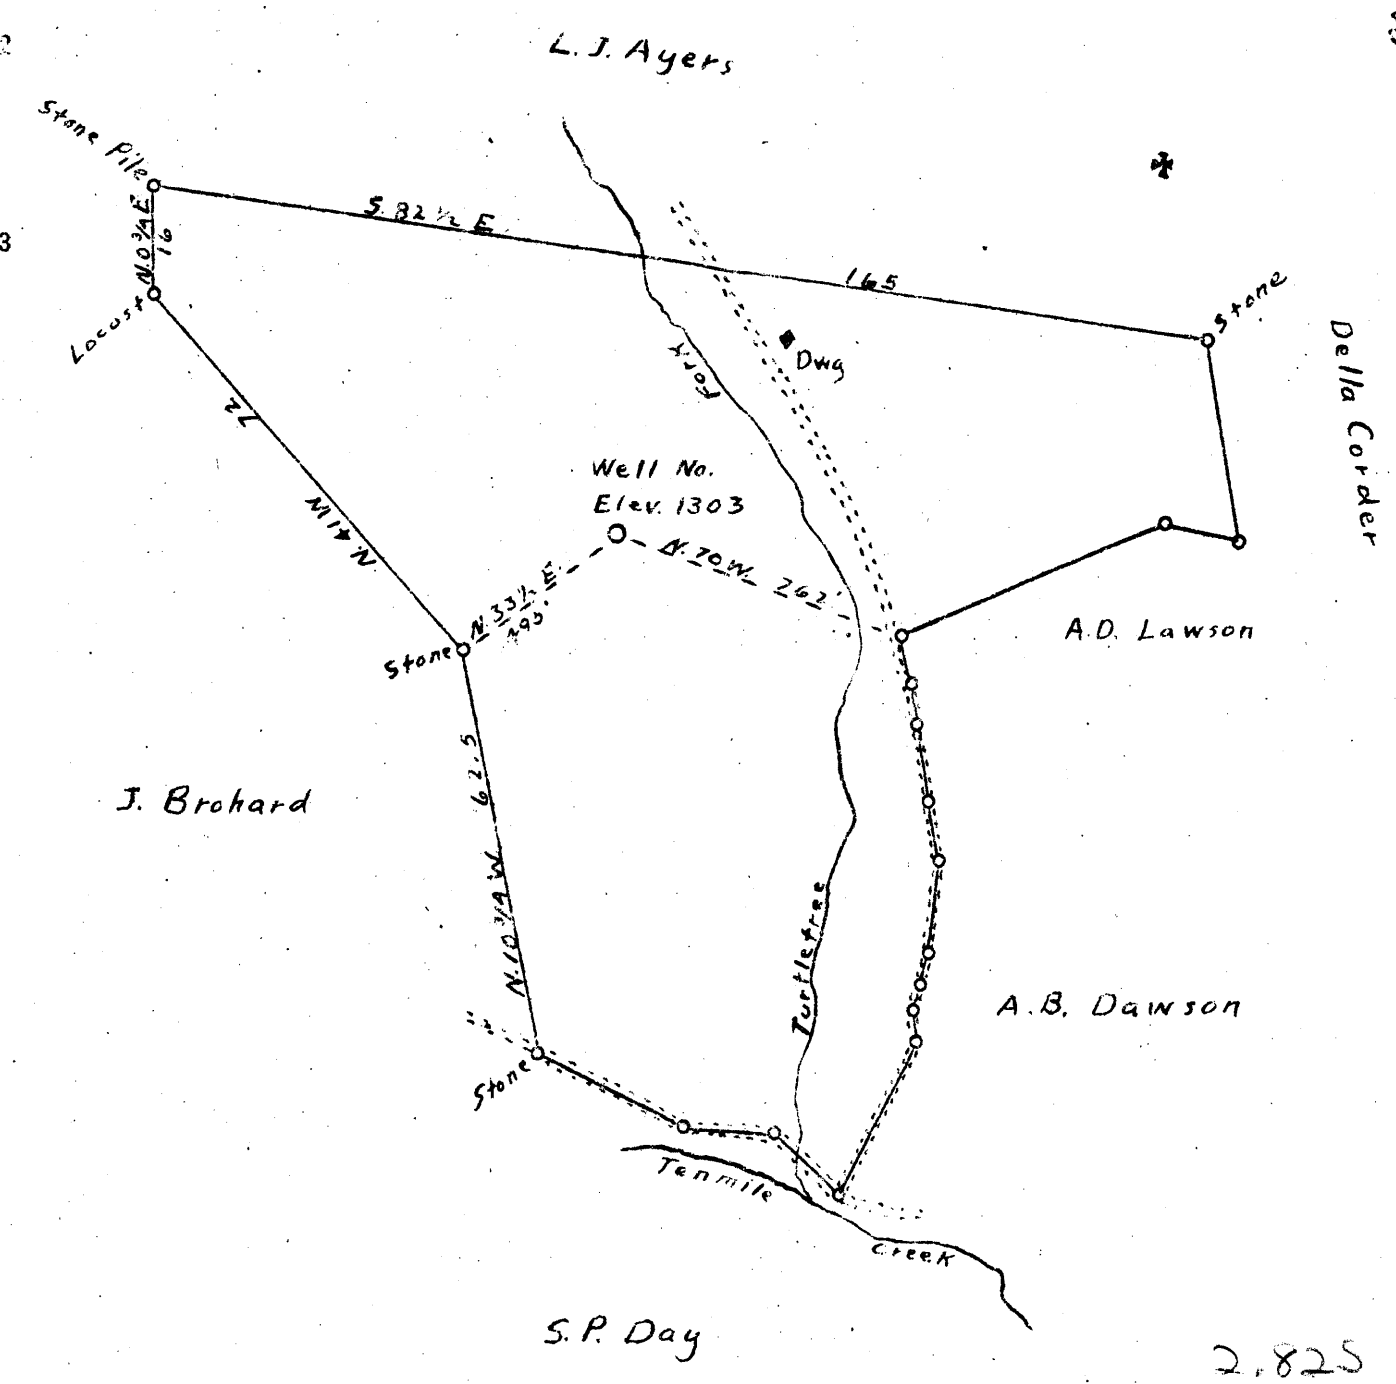

2,825
1.35W

New Location
Drill Deeper
Abandonment X

Company William Moses
 Address 189 W Main St. Salem, W Va.
 Farm R.M. Betts
 Tract _____ Acres 71.5 Lease No. _____
 Well (Farm) No. 5 Serial No. _____
 Elevation (Spirit Level) 1303
 Quadrangle Vadis
 County Harrison District Union
 Engineer A.K. Westfall
 Engineer's Registration No. _____
 File No. _____ Drawing No. _____
 Date Oct. 8, 1946 Scale 1" = 30 Poles

STATE OF WEST VIRGINIA
 DEPARTMENT OF MINES
 OIL AND GAS DIVISION
 CHARLESTON

WELL LOCATION MAP
 FILE NO. HAR-1075-A

+ Denotes location of well on United States Topographic Maps, scale 1 to 62,500, latitude and longitude lines being represented by border lines as shown.

- Denotes one inch spaces on border line of original tracing.



STATE OF WEST VIRGINIA
DEPARTMENT OF MINES
OIL AND GAS DIVISION

889

WELL RECORD

Oil or Gas Well Gas
(KIND)

Permit No. AP 1075-A

Company William Moses
Address Salem, W. Va
Farm A Coffindaffer (7. m. Better) acres 71.5
Location (waters) _____
Well No. 5 Elev. 1303
District Union County Harrison
The surface of tract is owned in fee by William Moses
Address Salem, W. Va
Mineral rights are owned by No Coal Operations
Address _____
Drilling commenced Nov. 19, 1901
Drilling completed Feb. 18, 1902
Date Shot _____ From _____ To _____
With _____

Casing and Tubing	Used in Drilling	Left in Well	Packers
Size			Kind of Packer
16			
13			Size of
8 1/4		<u>2050</u>	Depth set
6 3/4			
5 3/16			Perf. top
3		<u>2955</u>	Perf. bottom
2			Perf. top
Liners Used			Perf. bottom

Open Flow _____ /10ths Water in _____ Inch
_____ /10ths Merc. in _____ Inch
Volume _____ Cu. Ft.
Rock Pressure _____ lbs. _____ hrs.
Oil _____ bbls., 1st 24 hrs.
Fresh water _____ feet _____ feet
Salt water _____ feet _____ feet

CASING CEMENTED _____ SIZE _____ No. Ft. _____ Date _____
COAL WAS ENCOUNTERED AT 638 FEET _____ INCHES
_____ FEET _____ INCHES _____ FEET _____ INCHES
_____ FEET _____ INCHES _____ FEET _____ INCHES

Formation	Color	Hard or Soft	Top	Bottom	Oil, Gas or Water	Depth Found	Remarks
			<u>638</u>	<u>642</u>			
			<u>1170</u>	<u>1210</u>			
			<u>1590</u>	<u>1765</u>			
			<u>1900</u>	<u>2015</u>			
			<u>2020</u>	<u>2045</u>			
			<u>2050</u>	<u>2150</u>			
			<u>2660</u>	<u>2710</u>			
			<u>2721</u>	<u>2770</u>			
			<u>2941</u>	<u>2946</u>			
			<u>Total Depth</u>	<u>2965</u>			

(C)

