


0
1
2
3

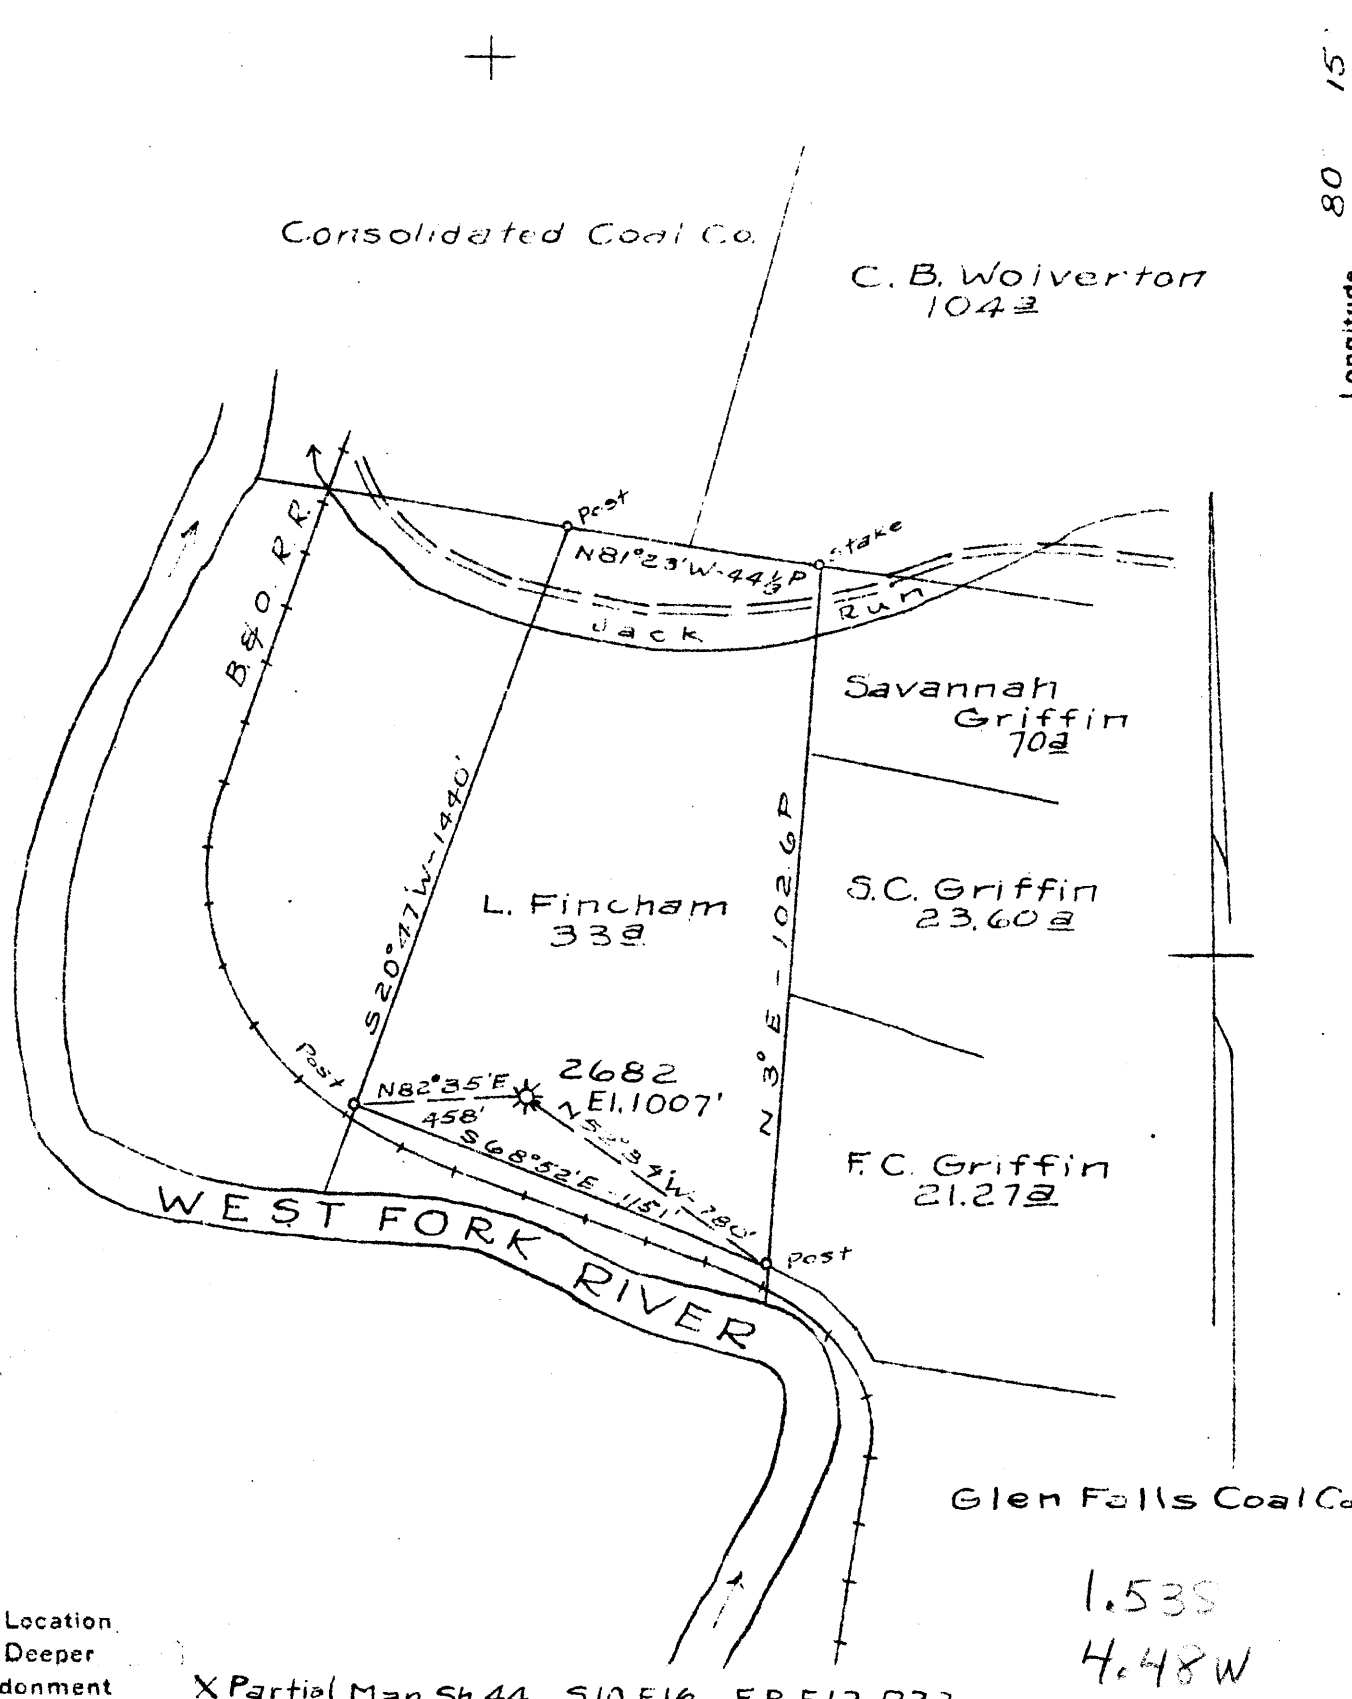

New Location
Drill Deeper
Abandonment

X Partial Map Sh. 44 S10 E16 F.B 512 P32

Company HOPE NATURAL GAS CO.

Address CLARKSBURG, W.VA.

Farm L. FINCHAM

Tract Acres 33 Lease No. 13986

Well (Farm) No. Serial No. 2682

Elevation (Spirit Level) 1007'

Quadrangle CLARKSBURG

County HARRISON District COAL

Engineer W.M. Bowers

Engineer's Registration No. 900

File No. Drawing No.

Date 5-29-47 Scale 1" = 500'

STATE OF WEST VIRGINIA
DEPARTMENT OF MINES
OIL AND GAS DIVISION
CHARLESTON

WELL LOCATION MAP
FILE NO. HAR-1083-A

+ Denotes location of well on United States Topographic Maps, scale 1 to 62,500, latitude and longitude lines being represented by border lines as shown.

- Denotes one inch spaces on border line of original tracing



STATE OF WEST VIRGINIA
DEPARTMENT OF MINES
OIL AND GAS DIVISION

893

WELL RECORD

Permit No. 1083-A Oil Gas Well (KIND)


Company Hope Natural Gas Company.
Address 445 West Main St. Clarksburg, W. Va.
Farm L. Fine an Acres 33
Location (waters) _____
Well No. 2682 Elev. 1007
District Coal. County Harrison
The surface of tract is owned in fee by _____
Address _____

Casing and Tubing	Used in Drilling	Left in Well	Packers
Size			
16			Kind of Packer
13			
10	150	Pulled	Size of
8 1/4	843	Pulled	
6 5/8	1420	1420	Depth set
5 3/16	2220	2220	
3			Perf. top
2	3119	Pulled	Perf. bottom
Liners Used			Perf. top
			Perf. bottom

Mineral rights are owned by _____
Address _____
Drilling commenced November 7, 1912
Drilling completed December 20, 1912
Date Shot _____ From _____ To _____
With _____
Open Flow _____ /10ths Water in _____ Inch
_____ /10ths Merc. in _____ Inch
Volume _____ Cu. Ft.
Rock Pressure _____ lbs. _____ hrs.
Oil _____ bbls., 1st 24 hrs.
Fresh water 335 feet _____ feet
Salt water _____ feet _____ feet

CASING CEMENTED **NOT** SIZE _____ No. Ft. _____ Date _____
COAL WAS ENCOUNTERED AT **Below** FEET _____ INCHES _____
FEET _____ INCHES FEET _____ INCHES
FEET _____ INCHES FEET _____ INCHES

Formation	Color	Hard or Soft	Top	Bottom	Oil, Gas or Water	Depth Found	Remarks
Little Dunkard			325	350	water	335	
Big Dunkard			575	620			
Gas sand			666	720			
First Salt			736	770			
Second Salt			910	1015			
Little Lime			1355	1360			
Pencil cave			1380	1365			
Big Lime			1365	1410			
Big Injun			1410	1525	gas	1419	
Berea			1630	1660			
Fifty foot			1940	2005	gas	1965	
Thirty foot			2010	2095			
Gordon stray			2204	2214			
Gord m			2250	2262			
Fifth			2380	2428	gas	2383 2417	
Speechley			3085	3097	gas	3088	
Total depth				3119			

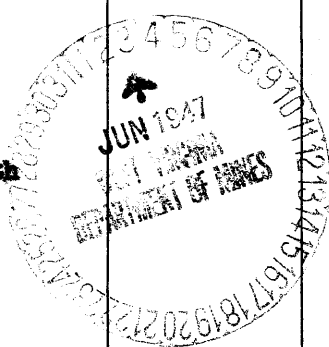

AUG 20 1947

Formation	Color	Hard or Soft	Top	Bottom	Oil, Gas or Water	Depth Found	Remarks

Date May 29, 1947., 19__

APPROVED Hope Natural Gas Company., Owner

By *[Signature]* General Superintendent.
(Title)

