

0.315
3.89W

New Location
 Drill Deeper
 Abandonment in part

Map Sh. 41-59-E 16-FB.865 P-12-13.

Company	Hope Natural Gas Co.
Address	Clarksburg, W.Va.
Farm	Coffman-Haymaker
Tract	Acres 33 1/3 Lease No. 25988
Well (Farm) No.	Serial No. 3165
Elevation (Spirit Level)	1014'
Quadrangle	Clarksburg
County	Harrison District Coal
Engineer	W.M. Brewer
Engineer's Registration No.	900
File No.	Drawing No.
Date 6-25-47	Scale 1"=40 P.

STATE OF WEST VIRGINIA
 DEPARTMENT OF MINES
 OIL AND GAS DIVISION
 CHARLESTON

WELL LOCATION MAP
 FILE NO. HAR-1092-A

+ Denotes location of well on United States Topographic Maps, scale 1 to 62,500. latitude and longitude lines being represented by border lines as shown.

- Denotes one inch spaces on border line of original tracing.



STATE OF WEST VIRGINIA
DEPARTMENT OF MINES
OIL AND GAS DIVISION

895

WELL RECORD


Permit No. 1092-A or Gas Well _____ (KIND)

Company Hope Natural Gas Company.
 Address 445 West Main St. Clarksburg, W. Va.
 Farm Coffman Haymaker Acres 207
 Location (waters) _____
 Well No. 3165 Elev. 1014
 District Coal County Harrison
 The surface of tract is owned in fee by _____
 Address _____
 Mineral rights are owned by _____
 Address _____
 Drilling commenced Oct. 15, 1913
 Drilling completed Nov. 28, 1913
 Date Shot _____ From _____ To _____
 With _____
 Open Flow _____ /10ths Water in _____ Inch
 _____ /10ths Merc. in _____ Inch
 Volume _____ Cu. Ft.
 Rock Pressure _____ lbs. _____ hrs.
 Oil _____ bbls., 1st 24 hrs.
 Fresh water _____ feet _____ feet
 Salt water 920 feet _____ feet

Casing and Tubing	Used in Drilling	Left in Well	Packers
Size			
16			Kind of Packer _____
13			
10	184	184	Size of _____
8 1/4	1020	1020	
6 5/8	<input checked="" type="checkbox"/> 1458	1458	Depth set _____
5 3/16	2187	2187	
3			Perf. top _____
2	3167	Pulled	Perf. bottom _____
Liners Used			Perf. top _____
			Perf. bottom _____

CASING CEMENTED NOT SIZE _____ No. Ft. _____ Date _____
 none recorded
 COAL WAS ENCOUNTERED AT _____ FEET _____ INCHES
 _____ FEET _____ INCHES FEET _____ INCHES
 _____ FEET _____ INCHES FEET _____ INCHES

Formation	Color	Hard or Soft	Top	Bottom	Oil, Gas or Water	Depth Found	Remarks
Little Dunkard			355	420			
Big Dunkard			442	478			
Gas sand			565	610			
First Salt			725	958	water	920	
Second Salt			970	1020			
Little Lime			1360	1375			
Pencil cave			1375	1390			
Big Lime			1390	1447			
Big Injun			1447	1552	gas	1455	
Fifty foot			1900	1950			
Thirty foot			1970	2075			
Gordon stray			2174	2245			
Gordon			2251	2305			
Fifth			2437	2458	gas	2440	
Speechley			3140	3146	gas	3142	
Total depth				3167			

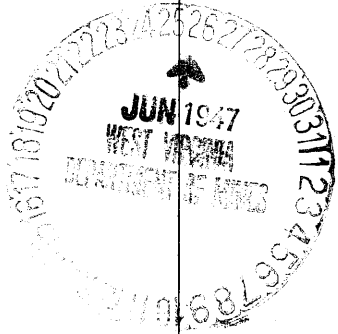

AUG 20 1947

Formation	Color	Hard or Soft	Top	Bottom	Oil, Gas or Water	Depth Found	Remarks

Date June 18, 1947, 194

APPROVED Hope Natural Gas Company., Owner

By E.H. Jolley
General Superintendent.
(Title)

