


Latitude 39° 25'

Longitude 80 36'

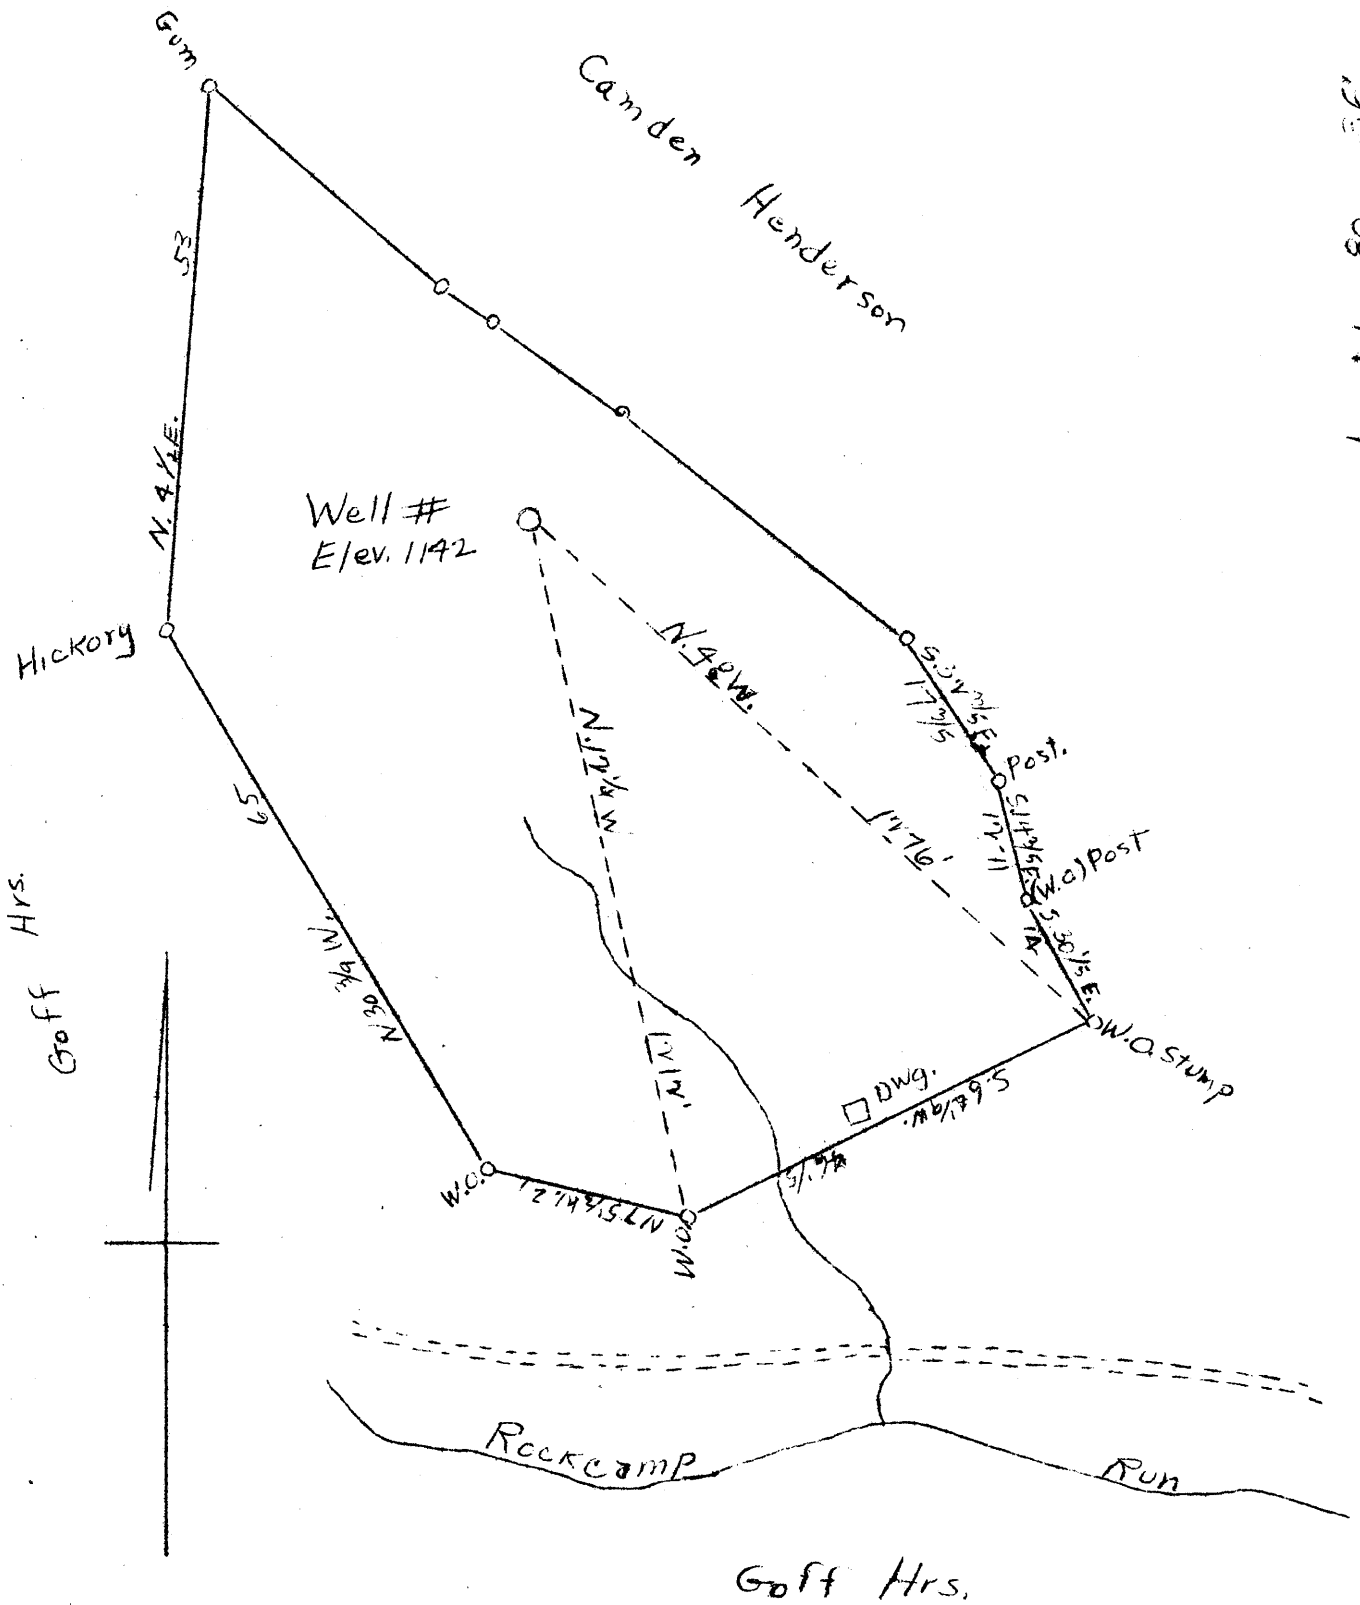

Abandonment

Company William Moses
 Address 189 W. Main St., Salem, w.Va.
 Farm Asa L. Edgell
 Tract Acres 35 1/4 Lease No.
 Well (Farm No. 2 Serial No.)
 Elevation (Spirit Level) 1142
 Quadrangle Centerpoint
 County Harrison District Sardis
 Engineer A. K. Westfall
 Engineer's Registration No.
 File No. Drawing No.
 Date Dec. 15, 1947 Scale 1" - 20 Poles

STATE OF WEST VIRGINIA
 Department of Mines
 OIL AND GAS DIVISION
 Charleston

WELL LOCATION MAP
 File No. HAR - 1129-A-112

Denotes location of well on U.S. Topographic Maps, scale 1 to 62,500, latitude and longitude lines being represented by border lines as shown.

Denotes one inch spaces on border 1 line of original tracing.

plugged 2-16-48



STATE OF WEST VIRGINIA
DEPARTMENT OF MINES
OIL AND GAS DIVISION

951

WELL RECORD

Oil or Gas Well Oil
(KIND)

Permit No. 1097

Company William Moore
Address Safety W. 29
Farm J. W. Edgel Acres _____
Location (waters) _____
Well No. Two Elev. 1147
District Sandis County Harrison
The surface of tract is owned in fee by South River
Natural Gas Co Address Princeton, W. Va
Mineral rights are owned by No Coal operations
Address _____

Casing and Tubing	Used in Drilling	Left in Well	Packers
Size			
16			Kind of Packer
13			
10			Size of
8 3/4			
6 1/2		2235	Depth set
5 3/16		2978	
3			Perf. top
2		3105	Perf. bottom
Liners Used			Perf. top
			Perf. bottom

Drilling commenced _____
Drilling completed 9/16/55
Date Shot From _____ To _____
With _____
Open Flow /10ths Water in _____ Inch
/10ths Merc. in _____ Inch
Volume _____ Cu. Ft.
Rock Pressure _____ lbs. _____ hrs.
Oil _____ bbls., 1st 24 hrs.
Fresh water _____ feet _____ feet
Salt water _____ feet _____ feet

CASING CEMENTED _____ SIZE _____ No. Ft. _____ Date _____
COAL WAS ENCOUNTERED AT 964 FEET _____ INCHES
_____ FEET _____ INCHES _____ FEET _____ INCHES
_____ FEET _____ INCHES _____ FEET _____ INCHES

Formation	Color	Hard or Soft	Top	Bottom	Oil, Gas or Water	Depth Found	Remarks
			964	969			
			1427	1487			
			1885	1955			
			2185	2200			
			2210	2255			
			2288	2385			
			2855	2902			
			3007	3066			
			3077	3105			
			Total Depth				
				3105			

