

LATITUDE 39° 22' 30"

LONGITUDE 80° 30' 00"



2.85D
1.32W

7.5 OGIS topo location

7.5' loc _____ 15' loc _____
 _____ (calc.) _____

Company A.M. Snider


Farm Amos T. Morris

Quad Salem 7^{1/2}

County Harrison

District Ten Mile

WELL LOCATION MAP
 File No. Har-1142A

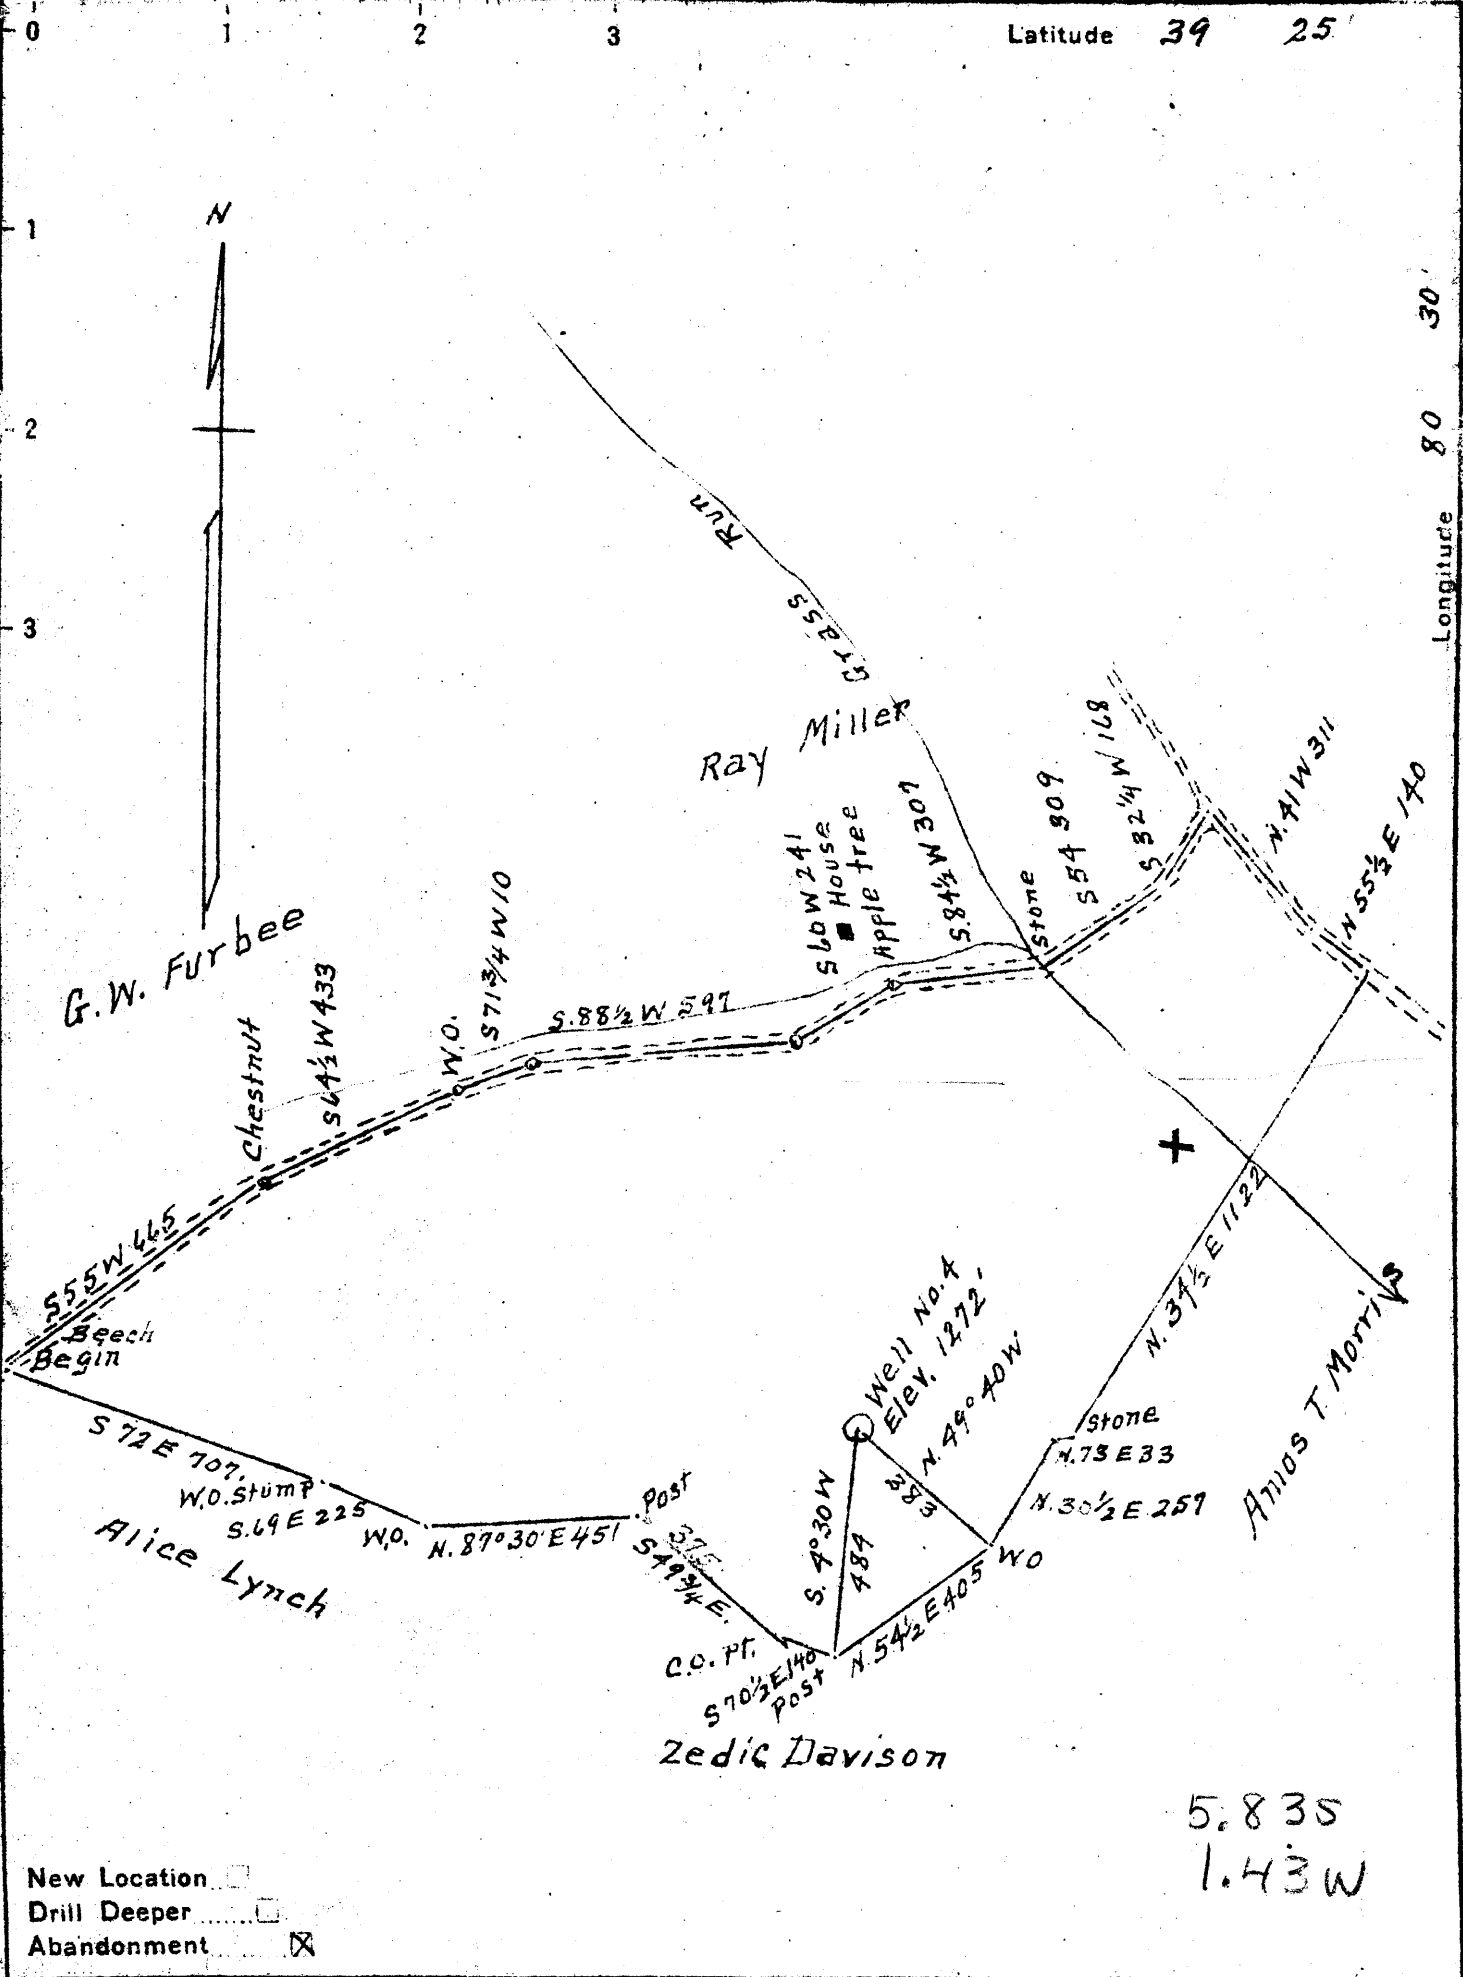

5.835
1.43W

New Location
 Drill Deeper
 Abandonment

Company A. M. Snider
 Address Hundred, W. Va
 Farm Amos T. Morris
 Tract 1 Acres 50 Lease No. _____
 Well (Farm) No. 4 Serial No. _____
 Elevation (Spirit Level) 1272
 Quadrangle Centerpoint
 County Harrison District Ten Mile
 Engineer A. L. Headley
 Engineer's Registration No. _____
 File No. _____ Drawing No. _____
 Date 1-28-48 Scale 1 inch = 400

STATE OF WEST VIRGINIA
 DEPARTMENT OF MINES
 OIL AND GAS DIVISION
 CHARLESTON

WELL LOCATION MAP
 FILE NO. HAR-1142-A

+ Denotes location of well on United States Topographic Maps, scale 1 to 62,500, latitude and longitude lines being represented by border lines as shown.
 - Denotes one inch spaces on border line of original tracing.



STATE OF WEST VIRGINIA
DEPARTMENT OF MINES
OIL AND GAS DIVISION

959

WELL RECORD

Permit No. 1142-A

Oil or Gas Well _____ (KIND)

Company S.M. Snider
 Address Hundred, W. Va.
 Farm Amos Morris Acres 50
 Location (waters) _____
 Well No. 4 Elev. 172
 District Ten Mile County Harrison
 The surface of tract is owned in fee by _____
 Address _____
 Mineral rights are owned by South Penn Natural Gas Co.
 Address Darkersburg, W. Va.
 Drilling commenced _____
 Drilling completed _____
 Date Shot _____ From _____ To _____
 With _____
 Open Flow _____ /10ths Water in _____ Inch
 _____ /10ths Merc. in _____ Inch
 Volume _____ Cu. Ft.
 Rock Pressure _____ lbs. _____ hrs.
 Oil _____ bbls., 1st 24 hrs.
 Fresh water _____ feet _____ feet
 Salt water _____ feet _____ feet

Casing and Tubing	Used in Drilling	Left in Well	Packers
Size			
16			Kind of Packer
13			
10			Size of
8 1/4			
6 5/8		2382	Depth set
5 3/16		2938	
3			Perf. top
2			Perf. bottom
Liners Used			Perf. top
			Perf. bottom

CASING CEMENTED _____ SIZE _____ No. Ft. _____ Date _____
 COAL WAS ENCOUNTERED AT 412 FEET 36 INCHES
970 FEET 72 INCHES FEET INCHES
 FEET INCHES FEET INCHES

Formation	Color	Hard or Soft	Top	Bottom	Oil, Gas or Water	Depth Found	Remarks
Native Coal			412	415			
Pgh. Coal			970	976			
Salt Sand.			1820	1875			
Maxon Sand.			2125	2155			
Big Lime.			2216	2262			
Big Injun.			2262	2358			
Gantz Sand.			2690	2730			
50' Ft. Sand.			2812	2846			
Stray Sand.			2966	2999			
Gordon Sand			3037	3061			
First Pay.			3039				
Second Pay.			3045	3062			
Total Depts.				3061			

23458
 FEB. 1948
 DEPARTMENT OF MINES

APR 8 1948