

#6 3.235
0.58W

#2 3.245
0.40W

Surface: Ruck Heater.
 RFD #2, Wallace Harrison Co., W.Va. Jno. Bramer
 Pittsburgh Coal: Mrs. Virginia A Tetrick et al. (formerly Gaddis & Co.)
 Address: Mrs. Virginia A Tetrick, 271 Clay St., Clarksburg, W.Va

New Location
 Drill Deeper
 Abandonment

On Acc Map # 3353. S6 E6

Company Carr Gawthrop & Sons.
 Address Bristol, Harrison Co., W.Va
 Farm J.T. Lanham
 Tract _____ Acres 140 Lease No. _____
 Well (Farm) No. 2nd 6 Serial No. _____
 Elevation (Spirit Level) See above at Wells
 Quadrangle CENTERPOINT
 County Harrison District Sardis
 Engineer E.C. Tabler
 Engineer's Registration No. _____
 File No. _____ Drawing No. _____
 Date Feb 10th 1949 Scale 1" = 400 Feet

STATE OF WEST VIRGINIA
 DEPARTMENT OF MINES
 OIL AND GAS DIVISION
 CHARLESTON

WELL LOCATION MAP

FILE NO. HAR-1147-A-#6
HAR-1148-A-#2

+ Denotes location of well on United States Topographic Maps, scale 1 to 62,500, latitude and longitude lines being represented by border lines as shown.

- Denotes one inch spaces on border line of original tracing



STATE OF WEST VIRGINIA
DEPARTMENT OF MINES
OIL AND GAS DIVISION

1023

WELL RECORD

Permit No. 1147-A

Oil or Gas Well (X)
(Kind)


Company Carr Gawthrop and Sons
Address Bristol, W. Va.
Farm J. T. Lanham Acres 140
Location (waters).....
Well No. 6 Elev. 1310.48
District Sardis County Harrison
The surface of tract is owned in fee by Ruck Heater
R. F. D. #2 Address Wallace, W. Va.
Mineral rights are owned by Mrs. Virginia A. Tetrick
271 Clay Street Address Clarksburg, W. Va.
Drilling commenced.....
Drilling completed No record
Date Shot From To
With

Casing and Tubing	Used in Drilling	Left in Well	Packers
Size			
16			Kind of Packer.....
18			Size of.....
10			Depth set.....
8 1/4			Perf. top.....
6	<u>2326'</u>	<u>2326'</u>	Perf. bottom.....
5 3/16			Perf. top.....
3			Perf. bottom.....
2	<u>3162'</u>	<u>None</u>	
Liners Used.....			

Open Flow /10ths Water in..... Inch
..... /10ths Merc. in..... Inch
Volume..... Cu. Ft.
Rock Pressure..... lbs..... hrs.
Oil..... bbls., 1st 24 hrs.
Fresh water..... feet..... feet
Salt water..... feet..... feet

CASING CEMENTED..... SIZE..... No. Ft..... Date.....
COAL WAS ENCOUNTERED AT 1030 FEET 60 INCHES
..... FEET..... INCHES..... FEET..... INCHES
..... FEET..... INCHES..... FEET..... INCHES

Formation	Color	Hard or Soft	Top	Bottom	Oil, Gas or Water	Depth Found	Remarks
Pittsburgh Coal			1025	1030			
Big Dunkard			1535	1597			
Big Lime			2340	2425			
Big Injun			2435	2557			
Fifty Foot			2878	2915	Gas-2905		
Thirty Foot			2980	3005			
Gordon Stray				3048			
Gordon			3109	3148			
Total Depth				3162			

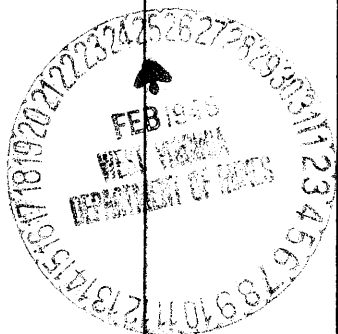

Formation	Color	Hard or Soft	Top	Bottom	Oil, Gas or Water	Depth Found	Remarks

Date February 24, 1948

APPROVED Carl Gauthier & Sons, Owner

By Carl Gauthier, owner
(Title)
Gen. Sec.