

#6 3.235  
0.58W

#2 3.245  
0.40W

Surface: Ruck Heater.  
 RFD #2, Wallace Harrison Co., W.Va. Jno. Bramer  
 Pittsburgh Coal: Mrs. Virginia A Tetrick et al. (formerly Gaddis & Co.)  
 Address: Mrs. Virginia A Tetrick, 271 Clay St., Clarksburg, W.Va.

- New Location
- Drill Deeper
- Abandonment

On 400' Map # 3353. S6 E6

Company Carr Gauthrop & Sons.  
 Address Bristol, Harrison Co., W.Va.  
 Farm J.T. Lanham  
 Tract \_\_\_\_\_ Acres 140 Lease No. \_\_\_\_\_  
 Well (Farm) No. 2<sup>nd</sup> 6 Serial No. \_\_\_\_\_  
 Elevation (Spirit Level) See above at Wells  
 Quadrangle CENTERPOINT  
 County Harrison District Sardis  
 Engineer E.C. Tabler  
 Engineer's Registration No. \_\_\_\_\_  
 File No. \_\_\_\_\_ Drawing No. \_\_\_\_\_  
 Date Feb 10<sup>th</sup> 1949 Scale 1" = 400 Feet

STATE OF WEST VIRGINIA  
 DEPARTMENT OF MINES  
 OIL AND GAS DIVISION  
 CHARLESTON

WELL LOCATION MAP  
 FILE NO. HAR-1147-A-#6  
HAR-1148-A-#2

+ Denotes location of well on United States Topographic Maps, scale 1 to 62,500, latitude and longitude lines being represented by border lines as shown.  
 - Denotes one inch spaces on border line of original tracing



STATE OF WEST VIRGINIA  
DEPARTMENT OF MINES  
OIL AND GAS DIVISION

407

WELL RECORD

Permit No. 1492-A


Oil or Gas Well \_\_\_\_\_ (KIND)

Company Carr Gawthrop and Sons  
 Address Bristol, W. Va.  
 Farm J. T. Lanham Acres 140 A.  
 Location (waters) Wolf Pen run of Big Rock Camp  
 Well No. 2 Elev. 1096.57  
 District Sardis County Harrison  
 The surface of tract is owned in fee by Ruck Heater  
R.F. D. No. 2 Address Wallace, W.Va.  
 Mineral rights are owned by Mrs. Virginia A. Tetrick  
271 Clay Street Address Clarksburg, W.Va.  
 Drilling commenced \_\_\_\_\_  
 Drilling completed No record  
 Date Shot \_\_\_\_\_ From \_\_\_\_\_ To \_\_\_\_\_  
 With \_\_\_\_\_  
 Open Flow \_\_\_\_\_ /10ths Water in \_\_\_\_\_ Inch  
 \_\_\_\_\_ /10ths Merc. in \_\_\_\_\_ Inch  
 Volume \_\_\_\_\_ Cu. Ft.  
 Rock Pressure \_\_\_\_\_ lbs. \_\_\_\_\_ hrs.  
 Oil \_\_\_\_\_ bbls., 1st 24 hrs.  
 Fresh water \_\_\_\_\_ feet \_\_\_\_\_ feet  
 Salt water \_\_\_\_\_ feet \_\_\_\_\_ feet

| Casing and Tubing | Used in Drilling | Left in Well | Packers        |
|-------------------|------------------|--------------|----------------|
| Size              |                  |              | Kind of Packer |
| 16                |                  |              |                |
| 13                |                  |              |                |
| 10                |                  |              | Size of        |
| 8 1/4             |                  |              |                |
| 6 1/2             | <u>2078'</u>     | <u>2078'</u> | Depth set      |
| 5 3/16            | <u>2093'</u>     | <u>2093'</u> |                |
| 3                 |                  |              | Perf. top      |
| 2                 | <u>2912'</u>     | <u>2912'</u> | Perf. bottom   |
| Liners Used       |                  |              | Perf. top      |
|                   |                  |              | Perf. bottom   |

CASING CEMENTED \_\_\_\_\_ SIZE \_\_\_\_\_ No. Ft. \_\_\_\_\_ Date \_\_\_\_\_  
 COAL WAS ENCOUNTERED AT 797 FEET 60 INCHES  
 \_\_\_\_\_ FEET \_\_\_\_\_ INCHES FEET \_\_\_\_\_ INCHES  
 \_\_\_\_\_ FEET \_\_\_\_\_ INCHES FEET \_\_\_\_\_ INCHES

| Formation       | Color | Hard or Soft | Top  | Bottom | Oil, Gas or Water | Depth Found | Remarks |
|-----------------|-------|--------------|------|--------|-------------------|-------------|---------|
| Pittsburgh Coal |       |              | 792  | 797    |                   |             |         |
| Big Dunkard     |       |              | 1300 | 1365   |                   |             |         |
| Big Lime        |       |              | 2080 | 2160   |                   |             |         |
| Big Injun       |       |              | 2160 | 2265   |                   |             |         |
| Fifty Foot      |       |              | 2664 | 2684   |                   |             |         |
| Thirty Foot     |       |              | 2750 | 2780   |                   |             |         |
| Gordon Stray    |       |              | 2841 | 2866   |                   |             |         |
| Gordon          |       |              | 2886 | 2908   |                   |             |         |
| Total Depth     |       |              |      | 2912   |                   |             |         |

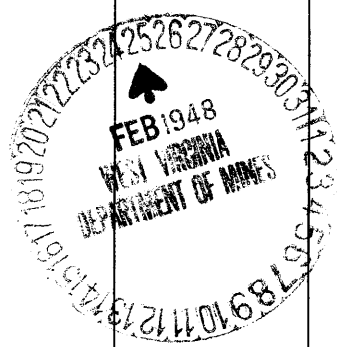

| Formation | Color | Hard or Soft | Top | Bottom | Oil, Gas or Water | Depth Found | Remarks |
|-----------|-------|--------------|-----|--------|-------------------|-------------|---------|
|           |       |              |     |        |                   |             |         |

Date February 24, 1948

APPROVED Law Sawthrop & Sons, Owner

By Law Sawthrop, owner  
S. M. Sec. (Title)

