

Surface: Brooks Cumberlege, RFD #3, Wallace, Harrison Co., W. Va.  
 Coal: Miss Margaret A. Tetric, 271 Clay St., Clarksburg, W. Va.

5.625  
3.86W

New Location...  
 Drill Deeper  
 Abandonment  On 400' map # 3153, S3 E7

Company	Strauss & Beren	
Address	Marietta, Ohio	
Farm	Wesley Robinson	
Tract	Acres 91	Lease No.
Well (Farm) No.	3	Serial No.
Elevation (Spirit Level)	Floor = 1313.20	Ground = 1310.70
Quadrangle	CLARKSBURG	
County	Harrison	District Sardis
Engineer	E.C. Tabler	
Engineer's Registration No.		
File No.	Drawing No.	
Date	April 9 <sup>th</sup> 1948 Scale Scale 1" = 400 Feet	

STATE OF WEST VIRGINIA  
 DEPARTMENT OF MINES  
 OIL AND GAS DIVISION  
 CHARLESTON

**WELL LOCATION MAP**  
 FILE NO. HAR-1180-A

+ Denotes location of well on United States Topographic Maps, scale 1 to 62,500, latitude and longitude lines being represented by border lines as shown.

- Denotes one inch spaces on border line of original tracing.



STATE OF WEST VIRGINIA  
DEPARTMENT OF MINES  
OIL AND GAS DIVISION

1031

WELL RECORD


Permit No. 1104 Oil or Gas Well X (KIND)

Company Strauss & Beron  
 Address Marietta, Ohio  
 Farm Wesley Robinson Acres 91  
 Location (waters) Middle Run  
 Well No. 3 Elev. 1313.20  
 District Sardis County Harrison  
 The surface of tract is owned in fee by Brooks Cumberland  
 Address 220 E. Wall St.  
 Mineral rights are owned by Miss Margaret A. Patrick  
 Address 271 Clay St., Clarksburg, W.Va.  
 Drilling commenced \_\_\_\_\_  
 Drilling completed \_\_\_\_\_  
 Date Shot \_\_\_\_\_ From \_\_\_\_\_ To \_\_\_\_\_  
 With \_\_\_\_\_  
 Open Flow \_\_\_\_\_ /10ths Water in \_\_\_\_\_ Inch  
 \_\_\_\_\_ /10ths Merc. in \_\_\_\_\_ Inch  
 Volume \_\_\_\_\_ Cu. Ft.  
 Rock Pressure \_\_\_\_\_ lbs. \_\_\_\_\_ hrs.  
 Oil \_\_\_\_\_ bbls., 1st 24 hrs.  
 Fresh water \_\_\_\_\_ feet \_\_\_\_\_ feet  
 Salt water \_\_\_\_\_ feet \_\_\_\_\_ feet

Casing and Tubing	Used in Drilling	Left in Well	Packers
Size			
16			Kind of Packer
13			
	300	None	Size of
8 1/4	1530	1530	
6	2425	2425	Depth set
5 3/16	3117	3117	
3			Perf. top
2			Perf. bottom
Liners Used			Perf. top
			Perf. bottom

CASING CEMENTED \_\_\_\_\_ SIZE \_\_\_\_\_ No. Ft. \_\_\_\_\_ Date \_\_\_\_\_  
 COAL WAS ENCOUNTERED AT 1017 FEET \_\_\_\_\_ INCHES  
 \_\_\_\_\_ FEET \_\_\_\_\_ INCHES FEET \_\_\_\_\_ INCHES  
 \_\_\_\_\_ FEET \_\_\_\_\_ INCHES FEET \_\_\_\_\_ INCHES

Formation	Color	Hard or Soft	Top	Bottom	Oil, Gas or Water	Depth Found	Remarks
Pgh. Coal			1017	1022			
Dunkard S.			1500	1525			
Salt S.			1857	1960			
Little Lime			2190	2205			
Pencil Cave			2205	2210			
Big Lime			2210	2285			
Big Injun			2285	2405			
50ft. S.			2880	2905			
Stray S.			3020	3075			
Gordon S.			3091	3129			
<b>Total Depth</b>				3135			

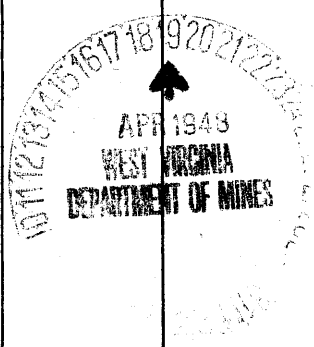

SEP 23 1948