


Latitude 39 + 25

Brooks Hutson

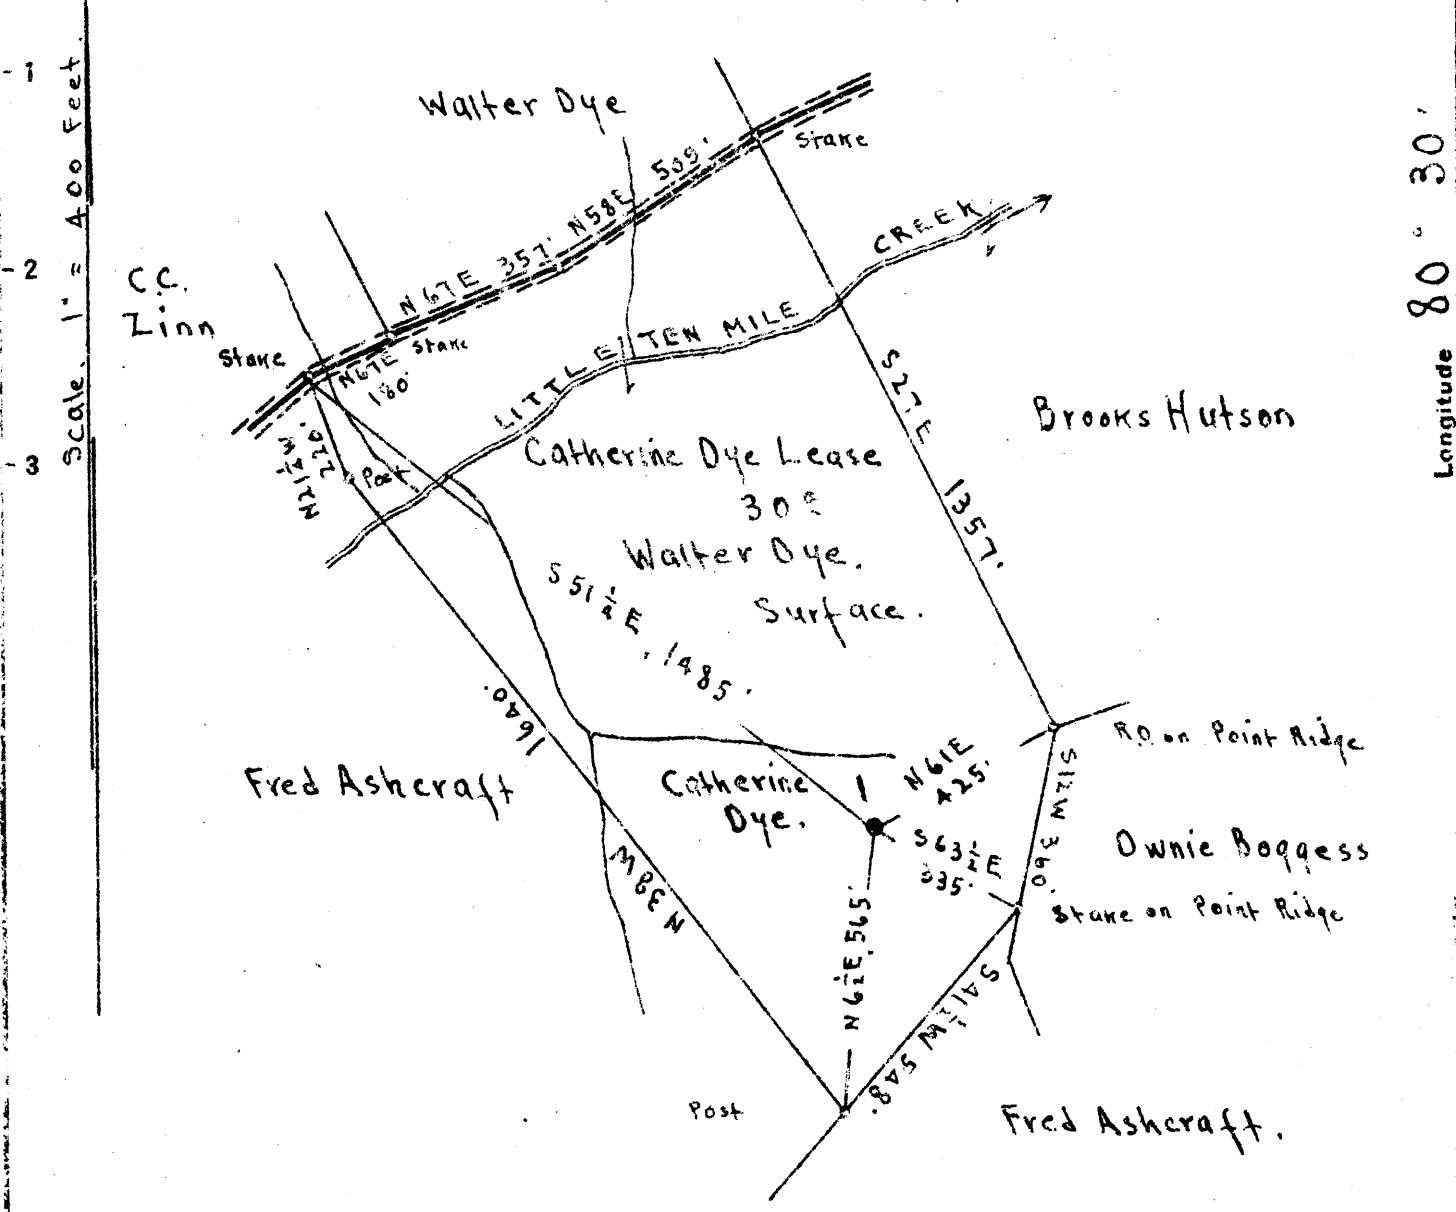

Surface: Walter Dye, Wallace, W.Va.
 Coal: Formerly Wallace Coal & Coke Co;
 now Miss Margaret Anne Tetrick
 271 Clay St, Clarksburg, W.Va.

0.435
 1.12 W

New Location
 Drill Deeper
 Abandonment

On 400' map # 3153

S 3 E 6

Company	Strauss & Beren	
Address	Marietta Ohio	
Farm	Catherine Dye	
Tract	Acres 30	Lease No.
Well (Farm) No.	1	Serial No.
Elevation (Spirit Level)	Floor = 1285.73	Ground = 1285.78
Quadrangle	CENTERPOINT	
County	Harrison	District Sardis
Engineer	E. C. Tobler	
Engineer's Registration No.		
File No.	Drawing No.	
Date	April 19 th 1948 Scale 1" = 400 Feet	

STATE OF WEST VIRGINIA
 DEPARTMENT OF MINES
 OIL AND GAS DIVISION
 CHARLESTON

WELL LOCATION MAP
 FILE NO. HAR-1197-A

+ Denotes location of well on United States Topographic Maps, scale 1 to 62,500, latitude and longitude lines being represented by border lines as shown.
 - Denotes one inch spaces on border line of original tracing.



STATE OF WEST VIRGINIA
DEPARTMENT OF MINES
OIL AND GAS DIVISION

176

WELL RECORD

Permit No. 1197-A Oil or Gas Well _____ (KIND)

Company Strauss & Beren
Address Marietta, Ohio
Farm Catherine Dye Acres 30
Location (waters) Little Ten Mile
Well No. 1 Elev 1285.78
District Sardis County Harrison
The surface of tract is owned in fee by Walter Dye
Address Wallace, W. Va.
Mineral rights are owned by Miss Margaret Anne
Tetrick Address 271 Clay Street,
Clarksburg, W. Va.
Drilling commenced _____
Drilling completed _____
Date Shot _____ From _____ To _____
With _____
Open Flow _____ /10ths Water in _____ Inch
_____ /10ths Merc. in _____ Inch
Volume _____ Cu. Ft.
Rock Pressure _____ lbs. _____ hrs.
Oil _____ bbls., 1st 24 hrs.
Fresh water _____ feet _____ feet
Salt water _____ feet _____ feet

Casing and Tubing	Used in Drilling	Left in Well	Packers
Size			
16			Kind of Packer
13			
10	375	375	Size of
8 1/4	1573	1543	
6 3/8	2337	2337	Depth set
5 3/16	2622	2622	
3			Perf. top
2			Perf. bottom
Liners Used	234' 4-4	1/2"	Perf. top
	Set at 2898'		Perf. bottom

CASING CEMENTED _____ SIZE _____ No. Ft. _____ Date _____

COAL WAS ENCOUNTERED AT 1045 FEET _____ INCHES

_____ FEET _____ INCHES _____ FEET _____ INCHES

_____ FEET _____ INCHES _____ FEET _____ INCHES

Formation	Color	Hard or Soft	Top	Bottom	Oil, Gas or Water	Depth Found	Remarks
Coal, Pgh.			1045	1050			
Salt Sand			1596	1621			
Green Sand			1670	1710			
Big Lime			2265	2325			
Big Injun			2325	2450			
60' Sand			3102	3112			
Plate			3112	3137			
Gordon Sand			3137	3152			
Plate			3152	3192			
Total Depth				3192			

