

New Location   
 Drill Deeper   
 Abandonment

MAP SH. 44 S12 E12 FB 893 P-6

Company HOPE NATURAL GAS CO.  
 Address CLARKSBURG, W.V.A.  
 Farm NATHAN GOFF  
 Tract \_\_\_\_\_ Acres 0.5 Lease No. 60305  
 Well (Farm) No. \_\_\_\_\_ Serial No. 9243  
 Elevation (Spirit Level) 970  
 Quadrangle CLARKSBURG  
 County HARRISON District COAL  
 Engineer W.M. Bowers  
 Engineer's Registration No. 900  
 File No. \_\_\_\_\_ Drawing No. \_\_\_\_\_  
 Date 5-24-48 Scale 1" = 50'

STATE OF WEST VIRGINIA  
 DEPARTMENT OF MINES  
 OIL AND GAS DIVISION  
 CHARLESTON

WELL LOCATION MAP  
 FILE NO. HAR-1198-A

+ Denotes location of well on United States Topographic Maps, scale 1 to 62,500, latitude and longitude lines being represented by border lines as shown.  
 - Denotes one inch spaces on border line of original tracing.



STATE OF WEST VIRGINIA  
DEPARTMENT OF MINES  
OIL AND GAS DIVISION

1017

WELL RECORD


Permit No. 1192-A Oil or Gas Well (KIND)

Company Hope Natural Gas Company  
 Address 445 West Main St. Clarksburg, W. Va.  
 Farm Nathan Goff Acres 1/2  
 Location (waters) \_\_\_\_\_  
 Well No. 9243 Elev. 870  
 District Coal County Harrison  
 The surface of tract is owned in fee by \_\_\_\_\_  
 Address \_\_\_\_\_  
 Mineral rights are owned by \_\_\_\_\_  
 Address \_\_\_\_\_  
 Drilling commenced about 1914  
 Drilling completed \_\_\_\_\_  
 Date Shot \_\_\_\_\_ From \_\_\_\_\_ To \_\_\_\_\_  
 With \_\_\_\_\_  
 Open Flow \_\_\_\_\_ /10ths Water in \_\_\_\_\_ Inch  
 \_\_\_\_\_ /10ths Merc. in \_\_\_\_\_ Inch  
 Volume a purchased well Cu. Ft.  
 Rock Pressure \_\_\_\_\_ lbs. \_\_\_\_\_ hrs.  
 Oil \_\_\_\_\_ bbls., 1st 24 hrs.  
 Fresh water no record feet \_\_\_\_\_ feet  
 Salt water " " feet \_\_\_\_\_ feet

Casing and Tubing	Used in Drilling	Left in Well	Packers
Size			
16			Kind of Packer
13			
10	<u>242</u>	<u>Pulled</u>	Size of
8 1/4	<u>916</u>	<u>Pulled</u>	
6 5/8	<u>1316</u>	<u>1316</u>	Depth set
5 3/16			
3			Perf. top
2			Perf. bottom
Liners Used			Perf. top
			Perf. bottom

CASING CEMENTED \_\_\_\_\_ SIZE Not No. Ft. \_\_\_\_\_ Date \_\_\_\_\_  
 COAL WAS ENCOUNTERED AT below FEET \_\_\_\_\_ INCHES \_\_\_\_\_  
 FEET \_\_\_\_\_ INCHES FEET \_\_\_\_\_ INCHES  
 FEET \_\_\_\_\_ INCHES FEET \_\_\_\_\_ INCHES

Formation	Color	Hard or Soft	Top	Bottom	Oil, Gas or Water	Depth Found	Remarks
<u>Little Dunkard</u>			<u>330</u>	<u>368</u>			
<u>Big Dunkard</u>			<u>510</u>	<u>570</u>			
<u>1st Salt sand</u>			<u>665</u>	<u>775</u>			
<u>Big Lime</u>			<u>1225</u>	<u>1268</u>			
<u>Big Injun</u>			<u>1268</u>	<u>1386</u>			
<u>Fifty foot</u>			<u>1780</u>	<u>1863</u>	<u>gas</u>	<u>1807</u>	
<u>Fifth</u>			<u>2203</u>	<u>2218</u>	<u>gas</u>	<u>2205</u>	
<u>Total depth</u>				<u>2250</u>			

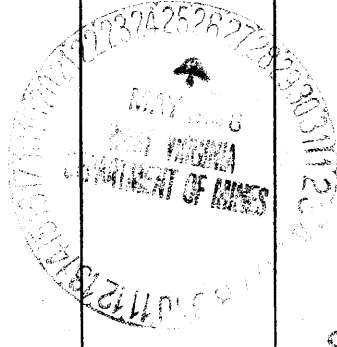

SEP 22 1948

Formation	Color	Hard or Soft	Top	Bottom	Oil, Gas or Water	Depth Found	Remarks

Date May 25, 1948, 19\_\_

APPROVED Hops Natural Gas Company., Owner

By \_\_\_\_\_

(Title) 