

0  
1  
2  
3

S. H. Day.

N 89°45' E 996'

Hy. Pts. O

ft. in road.

S. H. Day

Well # 2  
Elev. 1260'

Stone  
S. 73° W 40.5'

Stone  
N. 43° 40' E 254'

Stone  
N. 17° W 202'

Stone  
S. 18° 58' W 421'

Stone  
N. 71° W. 604'

Branch of Grass Run

ft. in road

ft. in road

S. H. Day.

N.



Surface = S. H. Day.

4.835  
0.82W

- New Location
- Drill Deeper
- Abandonment

Company A. M. Snider  
 Address Hundred W. Va.  
 Farm James F. Dye.  
 Tract 1 Acres 11 Lease No. \_\_\_\_\_  
 Well (Farm) No. 2 Serial No. \_\_\_\_\_  
 Elevation (Spirit Level) 1260'  
 Quadrangle Centerpoint  
 County Harrison District Tennile  
 Engineer A. L. Headly  
 Engineer's Registration No. \_\_\_\_\_  
 File No. \_\_\_\_\_ Drawing No. \_\_\_\_\_  
 Date 5-28-1948 Scale 1" = 200'

STATE OF WEST VIRGINIA  
 DEPARTMENT OF MINES  
 OIL AND GAS DIVISION  
 CHARLESTON

WELL LOCATION MAP  
 FILE NO. HAR-1203-A

+ Denotes location of well on United States Topographic Maps, scale 1 to 62,500, latitude and longitude lines being represented by border lines as shown.

- Denotes one inch spaces on border line of original tracing.



STATE OF WEST VIRGINIA  
DEPARTMENT OF MINES  
OIL AND GAS DIVISION

1014

WELL RECORD


Permit No. \_\_\_\_\_ Oil or Gas Well \_\_\_\_\_ (KIND)

Company A. W. Snider  
 Address Hundred, W. Va  
 Farm James F. Dye Acres 11  
 Location (waters) \_\_\_\_\_  
 Well No. 2 Elev. 1760  
 District Ten Mile County Harrison  
 The surface of tract is owned in fee by \_\_\_\_\_  
 Address \_\_\_\_\_  
 Mineral rights are owned by \_\_\_\_\_  
 Address \_\_\_\_\_  
 Drilling commenced \_\_\_\_\_  
 Drilling completed 3/22/04  
 Date Shot \_\_\_\_\_ From \_\_\_\_\_ To \_\_\_\_\_  
 With \_\_\_\_\_  
 Open Flow \_\_\_\_\_ /10ths Water in \_\_\_\_\_ Inch  
 \_\_\_\_\_ /10ths Merc. in \_\_\_\_\_ Inch  
 Volume \_\_\_\_\_ Cu. Ft.  
 Rock Pressure \_\_\_\_\_ lbs. \_\_\_\_\_ hrs.  
 Oil \_\_\_\_\_ bbls., 1st 24 hrs.  
 Fresh water \_\_\_\_\_ feet \_\_\_\_\_ feet  
 Salt water \_\_\_\_\_ feet \_\_\_\_\_ feet

Casing and Tubing	Used in Drilling	Left in Well	Packers
Size			Kind of Packer
16			
13			
10			Size of
8 1/4			
6 3/8	<u>2185</u>		Depth set
5 3/16	<u>2460</u>		
3			Perf. top
2			Perf. bottom
Liners Used			Perf. top
			Perf. bottom

CASING CEMENTED \_\_\_\_\_ SIZE \_\_\_\_\_ No. Ft. \_\_\_\_\_ Date \_\_\_\_\_  
 COAL WAS ENCOUNTERED AT 905 FEET 60 INCHES  
 \_\_\_\_\_ FEET \_\_\_\_\_ INCHES FEET \_\_\_\_\_ INCHES  
 \_\_\_\_\_ FEET \_\_\_\_\_ INCHES FEET \_\_\_\_\_ INCHES

Formation	Color	Hard or Soft	Top	Bottom	Oil, Gas or Water	Depth Found	Remarks
Red Con.			05	910			
Burford			1412	1440			
Salt			1760	1800			
Big Injun			2210	2315			
50ft			2770	2805			
Stacy			2933	2975			
Gordon			2996	3000	<u>Pay 3000</u>		
Total depth				3066			

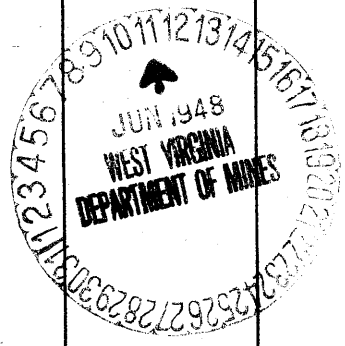

JAMES F. DYE NO. 2 WELL.

1203A

Tennile District, Harrison County, W. Va.

By A. M. Snider, Hundred, W. Va.

On 11 acres.

Elevation, 1260' L.

Drilling completed March 22, 1904.

6 $\frac{5}{8}$ " casing, 2184'; 5 $\frac{3}{8}$ " , 2400'.

Coal was encountered at 905-910'.

Oil well. Record to Dept. of Mines stamped June 11, 1948.

Record to RCT from Mrs. Griffith Sept. 23, 1948. Old File No. 1014.

	Top.	Bottom.
Pittsburgh Coal	905	- 910
Dunkard Sand	1412	- 1440
Salt Sand	1760	- 1920
Big Injun Sand	2210	- 2315
50-Ft. Sand	2770	- 2805
Stray Sand	2933	- 2975
Gordon Sand (pay, 3023')	2996	- 3030
Total depth		3066