

Coal; Formerly belonged to Short Line Fuel Co. Sold to State for Taxes in 1932. Redeemed in 1946 by Willis G. Tetrick Jr. et al. Address: Willis G. Tetrick Jr. 311 Clay St. Clarksburg, W. Va.

New Location   
 Drill Deeper   
 Abandonment

On AOC Map S1 E7

Company Sam Beren & Edward Strauss  
 Address Marietta, Ohio  
 Farm Luther Talkington  
 Tract \_\_\_\_\_ Acres 130 Lease No. \_\_\_\_\_  
 Well (Farm) No. 6 Serial No. \_\_\_\_\_  
 Elevation (Spirit Level) Floor 1130.96  
 Ground 1129.56  
 Quadrangle CLARKSBURG  
 County Harrison District Sardis  
 Engineer E. C. Tabler  
 Engineer's Registration No. \_\_\_\_\_  
 File No. \_\_\_\_\_ Drawing No. \_\_\_\_\_  
 Date Jan 17<sup>th</sup> 1948 Scale 1" = 400 Feet

STATE OF WEST VIRGINIA  
 DEPARTMENT OF MINES  
 OIL AND GAS DIVISION  
 CHARLESTON

**WELL LOCATION MAP**  
 FILE NO. HAR-1228-B

+ Denotes location of well on United States Topographic Maps, scale 1 to 62,500, latitude and longitude lines being represented by border lines as shown.

- Denotes one inch spaces on border line of original tracing.



STATE OF WEST VIRGINIA  
DEPARTMENT OF MINES  
OIL AND GAS DIVISION

1037


WELL RECORD

Permit No. Ab 1228-AW

Oil or Gas Well \_\_\_\_\_  
(KIND)

Company <u>Boren &amp; Strauss</u>	Casing and Tubing	Used in Drilling	Left in Well	Packers
Address <u>Marietta, Ohio</u>	Size			
Farm <u>Luther Talkington</u> Acres <u>130</u>	16			Kind of Packer
Location (waters) <u>Big Elk Run</u>	13			
Well No. <u>6</u> Elev. <u>1130.96</u>	10	<u>220</u>	<u>None</u>	Size of
District <u>Sardin</u> County <u>Harrison</u>	8 1/4	<u>1475</u>	<u>None</u>	Depth set
The surface of tract is owned in fee by <u>Harry Alkire</u>	6%	<u>2252</u>	<u>2252</u>	
Address <u>RFD #3, Wallace, W. Va.</u>	5 3/16	<u>2842</u>	<u>2842</u>	Perf. top
Mineral rights are owned by <u>Willis G. Tetrick, Jr.</u>	3			Perf. bottom
<u>et al</u> Address <u>311 Clay St.,</u>	2			Perf. top
<u>Clarksburg, W. Va.</u>	Liners Used <u>151' - 4 1/2" O.D.</u>			Perf. bottom
Drilling commenced	<u>liner. Up to 2850</u>			
Drilling completed				
Date Shot From To				
With				
Open Flow /10ths Water in _____ Inch	CASING CEMENTED _____ SIZE _____ No. Ft. _____ Date _____			
_____ /10ths Merc. in _____ Inch				
Volume _____ Cu. Ft.				
Rock Pressure _____ lbs. _____ hrs.	COAL WAS ENCOUNTERED AT <u>980</u> FEET _____ INCHES			
Oil _____ bbls., 1st 24 hrs.	_____ FEET _____ INCHES FEET _____ INCHES			
Fresh water _____ feet _____ feet	_____ FEET _____ INCHES FEET _____ INCHES			
Salt water _____ feet _____ feet				

Formation	Color	Hard or Soft	Top	Bottom	Oil, Gas or Water	Depth Found	Remarks
Pitts. Coal			980	985			
Big Lime			2180	2247			
Big Injun			2247	2355			
50' Sand			2826	2861			
30' Sand			2938	2958			
Stray Sand			2978	3042			
Gordon Sand			3054	3073			
Fourth Sand			3080	3087			
Total Depth				3088			

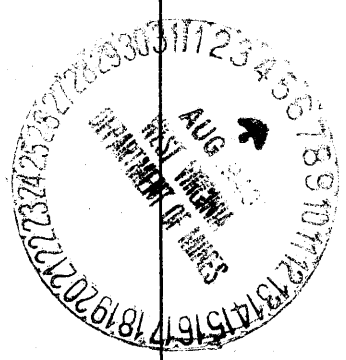

LUTHER TALKINGTON NO. 6 WELL.

Sardis District, Harrison County, W. Va.

1228A

By Beren P. Strauss, Marietta, Ohio.

Abandoned under permit Har-.....-A1

On 130 acres, on Elk Run.

Elevation, 1130.96' L.

Surface owned by Harry Alkire, R. F. D. No. 3, Wallace, W. Va., and

minerals by Willis G. Tetrick, Jr., at al., 311 Clay St.,

Clarksburg, W. Va.

10" casing, 220' (pulled); 8 1/2" , 1475' (pulled); 6" , 2252'; 5" , 2842';

4 1/2" G. W. liner, 151', up to 2850'.

Coal was encountered at 980-985'.

Oil well. Record to Dept. of Mines stamped Aug. 6, 1948.

Record to WPT from Mrs. Griffith Sept. 27, 1948. Old File No. 1037.

	Top.	Bottom.
Pittsburgh Coal	980	- 985
Big Lime	2180	- 2247
Big Injun Sand	2247	- 2355
50' Sand	2826	- 2861
30' Sand	2938	- 2958
Stray Sand	2978	- 3042
Gordon Sand	3054	- 3073
Fourth Sand	3080	- 3087
Total depth		3088