

Longitude 80 25



Surface: W.L. Bragg, RFD #1, Brown Harrison Co, W. Va.
 Coal: Miss Margaret Anne Tetrick, 271 Clay St, Clarksburg, W. Va.

New Location
 Drill Deeper
 Abandonment On 400' map # 315A S2 E8-9

Company Strauss & Beren
 Address Marietta, Ohio.
 Farm B.F. Heldreth.
 Tract _____ Acres 37 3/4 Lease No. _____
 Well (Farm) Nos. 1 and 3 Serial No. _____
 Elevation (Spirit Level) See above at wells.
 Quadrangle CLARKSBURG
 County Harrison District Sardis
 Engineer E.C. Tabler
 Engineer's Registration No. _____
 File No. _____ Drawing No. _____
 Date Aug 17th 1948 Scale 1" = 400 feet

STATE OF WEST VIRGINIA
 DEPARTMENT OF MINES
 OIL AND GAS DIVISION
 CHARLESTON

WELL LOCATION MAP

FILE NO. HAR-1261-A-#1
HAR-1264-A-#3

+ Denotes location of well on United States Topographic Maps, scale 1 to 62,500, latitude and longitude lines being represented by border lines as shown.
 - Denotes one inch spaces on border line of original tracing.

Plot 1261-A



STATE OF WEST VIRGINIA
DEPARTMENT OF MINES
OIL AND GAS DIVISION

1087

WELL RECORD

Oil or Gas Well _____
(KIND)

Permit No. 1264-A

Company Strauss & Beren
 Address Marietta, Ohio
 Farm B. F. Heldreth Acres 37
 Location (waters) Little Elk
 Well No. 3 Elev. 1376.84
 District Sardis County Harrison
 The surface of tract is owned in fee by W. L. Bragg
 Address RFD # 1, Brown, W. Va.
 Mineral rights are owned by Miss Margaret Anne
Tetrick Address 271 Clay Street,
Clarksburg, W. Va.
 Drilling commenced _____
 Drilling completed _____
 Date Shot _____ From _____ To _____
 With _____
 Open Flow _____ /10ths Water in _____ Inch
 _____ /10ths Merc. in _____ Inch
 Volume _____ Cu. Ft.
 Rock Pressure _____ lbs. _____ hrs.
 Oil _____ bbls., 1st 24 hrs.
 Fresh water _____ feet _____ feet
 Salt water _____ feet _____ feet

Casing and Tubing	Used in Drilling	Left in Well	Packers
Size			Kind of Packer
16			
13			
10	130'	130'	Size of
8	1484'	1484'	
6	2370'	2370'	Depth set
5 3/16			
2			Perf. top
			Perf. bottom
Liners Used			Perf. top
			Perf. bottom


CASING CEMENTED _____ SIZE _____ No. Ft. _____ Date _____

COAL WAS ENCOUNTERED AT 1022 FEET _____ INCHES

_____ FEET _____ INCHES FEET _____ INCHES

_____ FEET _____ INCHES FEET _____ INCHES

Formation	Color	Hard or Soft	Top	Bottom	Oil, Gas or Water	Depth Found	Remarks
Pitts. Coal			1022	1026			
Big Lime			2240	2315			
Big Injun			2315	2422			
Gordon, Stray			3044	3110			
Gordon Sand			3121	3146			
TOTAL DEPTH				3146			

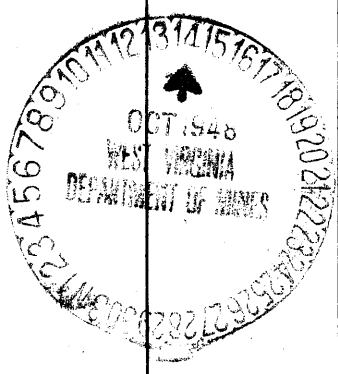

B. F. HELDRETH NO. 3 WELL.

1264A

Sardis District, Harrison County, W. Va.

By Strauss & Beren, Marietta, Ohio.

Abandoned under permit Har-.....-A?

On 37 acres, on Little Elk.

Elevation, 1376.84' L.

Surface owned by W. L. Bragg, R. F. D. No. 1, Brown, W. Va., and
minerals by Miss Margaret Anne Tetrick, 271 Clay St., Clarksburg, W.Va.

Date of completion not given.

10" casing, 130'; 8 $\frac{1}{4}$ " , 1484'; 6 $\frac{5}{8}$ " , 2370'; all left in.

Coal was encountered at 1022-1026'.

Oil well. Record to Dept. of Mines stamped Oct. 14, 1948.

Record to RCT from Mrs. Griffith Feb. 3, 1949. Old File No. 1087.

	Top.	Bottom.
Pittsburgh Coal	1022	- 1026
Big Lime	2240	- 2315
Big Injun Sand	2315	- 2422
Gordon Stray Sand	3044	- 3110
Gordon Sand	3121	- 3146
Total depth		3146