

Surface: F.S. Estlack, Wallace, Harrison Co. W. Va.

Pittsburgh Coal: Willis G. Tetrick Jr. et al. 311 Clay St. Clarksburg, W. Va.

4.22 S
0.86 W

New Location
 Drill Deeper
 Abandonment On 400' map, Sheet # 3053

S1 E6

Company Otis Eastern Service Inc.
 Address Bolivar, NY
 Farm O.E. Hall
 Tract Acres 175 ²⁵/₁₆₀ Lease No. 3
 Well (Farm) No. 3 Serial No. 1458.06
 Elevation (Spirit Level) Floor - 1458.06
Ground - 1454.03
 Quadrangle CENTERPOINT
 County Harrison District Sardis
 Engineer Ernest C. Tabler
 Engineer's Registration No. 2005
 File No. _____ Drawing No. _____
 Date Oct. 9th 1948 Scale 1" = 400 Feet.

STATE OF WEST VIRGINIA
 DEPARTMENT OF MINES
 OIL AND GAS DIVISION
 CHARLESTON

WELL LOCATION MAP
 FILE NO. HAR-1270-A

+ Denotes location of well on United States Topographic Maps, scale 1 to 62,500, latitude and longitude lines being represented by border lines as shown.

- Denotes one inch spaces on border line of original tracing.



STATE OF WEST VIRGINIA
DEPARTMENT OF MINES
OIL AND GAS DIVISION

1051

WELL RECORD

Permit No. 1270-A

Oil or Gas Well Oil
(KIND)

Company Otis Eastern Service, Inc.
 Address Box 929, Charleston, W. Va.
 Farm O. E. Hall Acres 143
 Location (waters) Middle Run
 Well No. 3 Elev. _____
 District Sardis County Harrison
 The surface of tract is owned in fee by _____
 Address _____
 Mineral rights are owned by _____
 Address _____
 Drilling commenced Sept. 24, 1903
 Drilling completed Nov. 25, 1903
 Date Shot _____ From _____ To _____
 With _____
 Open Flow _____ /10ths Water in _____ Inch
 _____ /10ths Merc. in _____ Inch
 Volume _____ Cu. Ft.
 Rock Pressure _____ lbs. _____ hrs.
 Oil _____ 25 bbls., 1st 24 hrs.
 Fresh water _____ feet _____ feet
 Salt water _____ feet _____ feet


Casing and Tubing	Used in Drilling	Left in Well	Packers
Size			
16			Kind of Packer <u>Larkin</u>
13			<u>Hook Wall</u>
10	<u>545'</u>	<u>Pulled</u>	Size of <u>5-3/16"</u>
8 1/4	<u>1775'</u>	<u>1775'</u>	
6 1/2	<u>2658'</u>	<u>2658'</u>	Depth set <u>3140'</u>
5 3/16	<u>3151'</u>	<u>3151'</u>	<u>12-5-28</u>
3			Perf. top _____
2" UE	<u>3376'</u>	<u>3376'</u>	Perf. bottom _____
Liners Used			Perf. top _____
			Perf. bottom _____

CASING CEMENTED _____ SIZE _____ No. Ft. _____ Date _____
 COAL WAS ENCOUNTERED AT 1280 FEET 84 INCHES
 _____ FEET _____ INCHES FEET _____ INCHES
 _____ FEET _____ INCHES FEET _____ INCHES

Formation	Color	Hard or Soft	Top	Bottom	Oil, Gas or Water	Depth Found	Remarks
Conductor				16			
Coal, Pittsburgh			1280	1287			
Little Dunkard			1685	1700			
Big Dunkard			1765	1780			
Gas			1980	2018			
Salt Sand			2163	2300			
Maxon Sand			2400	2468			
Pencil Cave			2468	2478			
Big Line			2478	2520			
Big Injun			2520	2658			
Fifty Foot			3120	3160			
Stray Sand			3320	3342			
Gordon Sand			3358	3377			
1st. Pay			3367				
Total Depth				3378			

Torpedo Record

Date	Qts.	Shell	Top	Bottom	Results
2-3-04	20	8'	3366'		
3-14-08	30	N.R.			
2-21-13	40	4"	3365'		
1-02-29	10	8'	3366'		No Good
1-08-29	60	10'	3366'		Fair

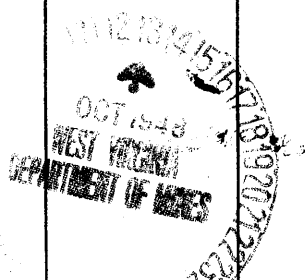

O. E. HALL NO. 3 WELL.

1270A

Sardis District, Harrison County, W. Va.

By Otis Eastern Service, Inc., Box 929, Charleston, W. Va.

Abandoned under permit Har-----A?

On 143 acres, on Middle Run.

Elevation, ' L.

Drilling commenced Sept. 24, 1903; completed Nov. 25, 1903.

Shot Feb. 3, 1904, with 20 qts., 8' shell, top, 3366'; March 14, 1908, with 30 qts., no record of shell or depth; Feb. 21, 1913, with 40 qts., 4" shell, top, 3365'; Jan. 2, 1929, with 10 qts., 8' shell, top, 3366', results, no good; Jan. 8, 1929, with 60 qts., 10' shell, top, 3366', results, fair.

Oil, 25 bbls., 1st 24 hrs.

10" casing, 545' (pulled); 8 $\frac{1}{4}$ " , 1775'; 6 $\frac{5}{8}$ " , 2658'; 5 $\frac{3}{8}$ " , 3151'; 2" U.E. tubing, 3376'.

Larkin hook wall packer, 5 $\frac{3}{8}$ " , set at 3140' Dec. 5, 1928.

Coal was encountered at 1280-1287'.

Oil well. Record to Dept. of Mines stamped Oct. 13, 1948.

Record to RCT from Mrs. Griffith Jan. 5, 1949. Old File No. 1051.

	Top.	Bottom.
Conductor	0	16
Pittsburgh Coal	1280	1287
Little Dunkard Sand	1685	1700
Big Dunkard Sand	1765	1780
Gas Sand	1980	2018
Salt Sand	2163	2300
Maxton Sand	2400	2468
Pencil Cave	2468	2478
Big Lime	2478	2520
Big Injun Sand	2520	2658
Fifty-foot Sand	3120	3160
Stray Sand	3320	3342
Gordon Sand (1st pay, 3367')	3358	3377
Total depth		3378