

Surface: A.M. Hustead, RFD #1, Wolf Summit, Harrison Co., W. Va.
 Coal: Mrs. Virginia A. Tetrick, 271 Clay St., Clarksburg, W. Va.

New Location
 Drill Deeper
 Abandonment On 400' map # 3653

S 12-13 E 6-7

Company W.M. Moses
 Address Salem, W. Va.
 Farm W.F. Williams
 Tract Acres 102.35 Lease No. 3
 Well (Farm) No. 3 Serial No. 1362.00
 Elevation Spirit Level Floor - 1299.50
Ground - 1299.50
 Quadrangle CENTERPOINT
 County Harrison District Tennile
 Engineer E.C. Tabler
 Engineer's Registration No. _____
 File No. _____ Drawing No. _____
 Date August 23, 1948 Scale 1" = 400 Feet

STATE OF WEST VIRGINIA
 DEPARTMENT OF MINES
 OIL AND GAS DIVISION
 CHARLESTON

WELL LOCATION MAP
 FILE NO. HAR-1291A

+ Denotes location of well on United States Topographic Maps, scale 1 to 25,000, altitude and longitude lines being represented by border lines as shown.
 - Denotes one inch spaces in border line of original tracing.



STATE OF WEST VIRGINIA
DEPARTMENT OF MINES
OIL AND GAS DIVISION

1082


WELL RECORD

Oil or Gas Well Oil
(KIND)

Permit No. 1291A

Company <u>William Moses</u>	Casing and Tubing	Used in Drilling	Left in Well	Packers
Address <u>Salem, W. Va.</u>	Size			
Farm <u>W. F. Williams</u> Acres <u>102</u>	16			Kind of Packer
Location (waters)	13			
Well No. <u>Nine</u> Elev. <u>1302</u>	10			Size of
District <u>Tennile</u> County <u>Harrison</u>	8 1/4			Depth set
The surface of tract is owned in fee by <u>South Penn Gas Co.</u>	6%		<u>2019</u>	
Address <u>Parkersburg</u>	5 3/16			Perf. top
Mineral rights are owned by <u>Mrs. Virginia A. Tetrick</u>	3			Perf. bottom
<u>271 Clay St.,</u> Address <u>Clarksburg, W. Va.</u>	2			Perf. top
Drilling commenced	Liners Used			Perf. bottom
Drilling completed <u>July 21, 1900</u>				
Date Shot From To				
With				
Open Flow /10ths Water in Inch	CASING CEMENTED	SIZE	No. Ft.	Date
/10ths Merc. in Inch				
Volume Cu. Ft.				
Rock Pressure lbs. hrs.	COAL WAS ENCOUNTERED AT	<u>600 FEET</u>	<u>INCHES</u>	
Oil bbls., 1st 24 hrs.				
Fresh water feet feet				
Salt water feet feet				

Formation	Color	Hard or Soft	Top	Bottom	Oil, Gas or Water	Depth Found	Remarks
Pitts Coal			600	607			
Dunkard Sand			1100	1185			
Big Lime			1935	2025			
Big Injun			2025	2100			
Fifty Foot			2500	2530			
Gordon Sand			2700	2750			
Fifth Sand			2905	2911			
Total Depth				2926			

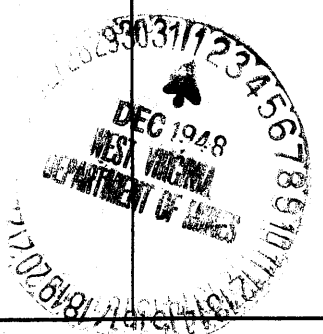

W. F. WILLIAMS NO. 9 WELL.

1291A

Tennile District, Harrison County, W. Va.

By William Moses, Salem, W. Va.

Abandoned under permit Har-----A?

On 102 acres.

Elevation, 1302' L.

Surface owned by South Penn Natural Gas Co., Parkersburg, W. Va., and minerals by Mrs. Virginia A. Tetrick, 271 Clay St., Clarksburg, W. Va.

Drilling completed July 21, 1900.

6 $\frac{3}{4}$ " casing, 2019'.

Coal was encountered at 600-607'.

Oil well. Record to Dept. of Mines stamped Dec. 1, 1948.

Record to RCT from Mrs. Griffith Jan. 22, 1949. Old File No. 1082.

	Top.	Bottom.
Pittsburgh Coal	600	- 607
Dunkard Sand	1100	- 1185
Big Lane	1935	- 2025
Big Injun Sand	2025	- 2100
Fifty-foot Sand	2500	- 2530
Gordon Sand	2700	- 2750
Fifth Sand	2905	- 2911
Total depth		2926