



New Location
 Drill Deeper
 Abandonment *West*

FB 684 P29 S18 E11 Sh 56

Company HOPE NATURAL GAS CO.
 Address CLARKSBURG, W. VA.
 Farm H.V. Williams
 Tract _____ Acres 10 Lease No. 52225
 Well (Farm) No. 1 Serial No. 7886
 Elevation (Spirit Level) 1038
 Quadrangle WESTON
 County HARRISON District UNION
 Engineer Wm Bowers
 Engineer's Registration No. 900
 File No. _____ Drawing No. _____
 Date 12-13-48 Scale 1" = 20 P.

STATE OF WEST VIRGINIA
 DEPARTMENT OF MINES
 OIL AND GAS DIVISION
 CHARLESTON

WELL LOCATION MAP
 FILE NO. HAR-1303-A

+ Denotes location of well on United States Topographic Maps, scale 1 to 62,500, latitude and longitude lines being represented by border lines as shown.

- Denotes one inch spaces on border line of original tracing.



STATE OF WEST VIRGINIA
DEPARTMENT OF MINES
OIL AND GAS DIVISION

1107

Ab 1303 A

WELL RECORD


Permit No. _____ Oil or Gas Well _____ (KIND)

Company Hope Natural Gas Company.
 Address 445 West Main St. Clarksburg, W. Va.
 Farm H.V. Williams Acres 10
 Location (waters) _____
 Well No. 7886 Elev. 1038
 District Union County Harrison
 The surface of tract is owned in fee by _____
 Address _____
 Mineral rights are owned by _____
 Address _____
 Drilling commenced Purchased well
 Drilling completed _____
 Date Shot _____ From _____ To _____
 With _____
 Open Flow _____ /10ths Water in _____ Inch
 _____ /10ths Merc. in _____ Inch
 Volume _____ Cu. Ft.
 Rock Pressure _____ lbs. _____ hrs.
 Oil _____ bbls., 1st 24 hrs.
 Fresh water no record feet _____ feet
 Salt water _____ feet _____ feet

Casing and Tubing	Used in Drilling	Left in Well	Packers
Size			Kind of Packer
16			
13			
10	<u>40</u>	<u>40</u>	Size of
8 1/2			
6 5/8	<u>1352</u>	<u>1352</u>	Depth set
5 3/16	<u>2296</u>	<u>2296</u>	
3			Perf. top
2			Perf. bottom
Liners Used			Perf. top
			Perf. bottom

CASING CEMENTED NOT SIZE _____ No. Ft. _____ Date _____
no record,
 COAL WAS ENCOUNTERED AT _____ FEET _____ INCHES
 _____ FEET _____ INCHES FEET _____ INCHES
 _____ FEET _____ INCHES FEET _____ INCHES

Formation	Color	Hard or Soft	Top	Bottom	Oil, Gas or Water	Depth Found	Remarks
Big Dunkard			648	668 EST			
Big Lime			1328	1403 EST			
Big Injun			1403	1523 EST			
Gordon			2110	2140			
Fifth			2263	2275	gas	2266	
Bayard			2295	2315			
Speachley			2958	2966	gas	2960	
Total depth				2966			

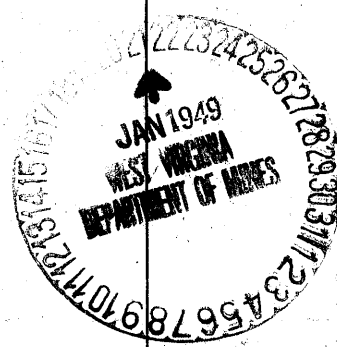

Formation	Color	Hard or Soft	Top	Bottom	Oil, Gas or Water	Depth Found	Remarks

Date January 20, 1949, 19

APPROVED Hops Natural Gas Company., Owner

By _____

(Title) *[Signature]*

H. V. WILLIAMS NO. 7886 WELL.

1303A

Union District, Harrison County, W. Va.

By Hope Natural Gas Co., 445 W. Main St., Clarksburg, W. Va.

Abandoned under permit Har-.....-A?

On 10 acres.

Elevation, 1038' L.

Purchased well. Date of completion, etc., not given.

No record of water.

10" casing, 40'; 6^{5/8}" 1352'; 5^{1/2}" 2298'; all left in.

Casing not cemented.

No record of coal.

Gas well. Abandonment reported to Dept. of Mines Jan. 20, 1949.

Record to RCT from Mrs. Griffith March 17, 1949. Old File No. 1107.

	Top.	Bottom.
Big Dunkard Sand	648	- 668 (Est.)
Big Lime	1328	- 1403 (Est.)
Big Injun Sand	1403	- 1523 (Est.)
Gordon Sand	2110	- 2140
Fifth Sand (gas, 2266')	2263	- 2275
Bayard Sand	2295	- 2315
Speechley Sand (gas, 2960')	2958	- 2966
Total depth		2966