

New Location
 Drill Deeper
 Abandonment X 4210-3

FB. 512 P. 17

Company HOPE NATURAL GAS CO.
 Address CLARKSBURG, W VA.
 Farm ROBT. WAGNER
 Tract _____ Acres 123 Lease No. _____
 Well (Farm) No. 123 Serial No. 2803 3899
 Elevation (Spirit Level) See Above
 Quadrangle WESTON
 County HARRISON District CLARK
 Engineer Wm Bowers
 Engineer's Registration No. 900
 No. _____ Drawing No. _____
SEPT. 2 1939 1"=500'

STATE OF WEST VIRGINIA
 DEPARTMENT OF MINES
 OIL AND GAS DIVISION
 CHARLESTON

WELL LOCATION MAP
 FILE NO. HAR-527-A

- + Denotes location of well on United States Topographic Maps, scale 1 to 62,500, latitude and longitude lines being represented by border lines as shown.
- Denotes one inch spaces on border line of original tracing.



STATE OF WEST VIRGINIA
DEPARTMENT OF MINES
OIL AND GAS DIVISION

1117

Permit No. AB 1314-A

WELL RECORD


Oil or Gas Well _____ (KIND)

Company Hops Natural Gas Company.
 Address 445 West Main St. Clarksburg, W. Va.
 Farm Robt. Wagner Acres 123
 Location (waters) _____
 Well No. 2803 Elev. 997
 District Clark County Harrison
 The surface of tract is owned in fee by _____
 Address _____
 Mineral rights are owned by _____
 Address _____
 Drilling commenced December 30, 1912
 Drilling completed January 22, 1913
 Date Shot _____ From _____ To _____
 With _____
 Open Flow _____ /10ths Water in _____ Inch
 _____ /10ths Merc. in _____ Inch
 Volume _____ Cu. Ft.
 Rock Pressure _____ lbs. _____ hrs.
 Oil _____ bbls., 1st 24 hrs.
 Fresh water 465 feet _____ feet
 Salt water 465 620 feet _____ feet

Casing and Tubing	Used in Drilling	Left in Well	Packers
Size			Kind of Packer
16			
18			
10	230	230	Size of
8 1/4	959	959	Depth set
6 5/8			
5 3/16			
3	1273	40	Perf. top
2			Perf. bottom
Liners Used			Perf. top
			Perf. bottom

CASING CEMENTED NOT SIZE _____ No. Ft. _____ Date _____
 Below
 COAL WAS ENCOUNTERED AT _____ FEET _____ INCHES
 _____ FEET _____ INCHES FEET _____ INCHES
 _____ FEET _____ INCHES FEET _____ INCHES

Formation	Color	Hard or Soft	Top	Bottom	Oil, Gas or Water	Depth Found	Remarks
Little Dunkard			238	270			
Big Dunkard			335	390			
Gas sand			445	478	water	465	
First Salt			503	630	water	620	
Second Salt			650	735			
Maxon			1198		gas	1230 1238	
Total depth				1268			

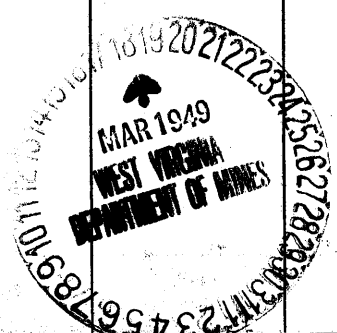

Formation	Color	Hard or Soft	Top	Bottom	Oil, Gas or Water	Depth Found	Remarks

Date March 17, 1949, 19

APPROVED Hope Natural Gas Company., Owner

By _____

(Title) *[Signature]*

ROBERT WAGNER NO. 2803 WELL.

Clark District, Harrison County, W. Va.
By Hope Natural Gas Co., 445 W. Main St., Clarksburg, W. Va.
Abandoned under permit Mar-.....-17

1314A

On 123 acres.

Elevat on, 997' L.

Drilling commenced Dec. 30, 1912; completed Jan. 28, 1913.

Salt water at 465 and 620'.

10" casing, 230'; 8" , 959'; 3" tubing, 1273' (40' left in).

Casing not cemented.

Starts below coal.

Gas well. Abandonment reported to Dept. of Mines March 17, 1949.

Record to RGT from Mrs. Griffith April 18, 1949. Old File No. 1117.

(on plat S27A)

	Top.	Bottom.
Little Burkard Sand	238	- 270
Big Burkard Sand	305	- 390
Gas Sand (water, 465')	445	- 478
First Salt Sand (water, 620')	503	- 630
Second Salt Sand	650	- 735
Maxton Sand (gas, 1230-1238')	1198	-
Total depth		1268