

- New Location
- Drill Deeper
- Abandonment

Map Sheet 58-59, 521E6 - FB 722 P. 36, 37

Company Hope Natural Gas Co.
 Address Clarksburg, W. Va.
 Farm E. G. Oldaker
 Tract _____ Acres 110 Lease No. 52908
 Well (Farm) No. 1 Serial No. 8130
 Elevation (Spirit Level) 1119
 Quadrangle Weston
 County Harrison District Union
 Engineer W. M. Bowes
 Engineer's Registration No. 901
 File No. _____ Drawing No. _____
 Date 3-17-41 Scale 1" = 40'

STATE OF WEST VIRGINIA
 DEPARTMENT OF MINES
 OIL AND GAS DIVISION
 CHARLESTON

WELL LOCATION MAP
 FILE NO. HAR-1320-A

+ Denotes location of well on United States Topographic Maps, scale 1 to 62,500, latitude and longitude lines being represented by dotted lines as shown.

- Denotes location of well on the original survey.



1139

STATE OF WEST VIRGINIA
DEPARTMENT OF MINES
OIL AND GAS DIVISION

WELL RECORD

Permit No. Ab 1300-A

~~Oil~~ Gas Well (KIND)


Company Hope Natural Gas Company
 Address 445-West Main St., Clarksburg, W.Va.
 Farm E. G. Oldaker Acres 110
 Location (waters) _____
 Well No. 8130 Elev. 1119
 District Union County Harrison
 The surface of tract is owned in fee by _____
 Address _____
 Mineral rights are owned by _____
 Address _____
 Drilling commenced June 25, 1918
 Drilling completed Aug. 26, 1918
 Date Shot _____ From _____ To _____
 With _____
 Open Flow _____ /10ths Water in _____ Inch
 _____ /10ths Merc. in _____ Inch
 Volume _____ Cu. Ft.
 Rock Pressure _____ lbs. _____ hrs.
 Oil _____ bbls., 1st 24 hrs.
 Fresh water None recorded feet _____ feet
 Salt water None recorded feet _____ feet

Casing and Tubing	Used in Drilling	Left in Well	Packers
Size			
16			Kind of Packer
13			
10	154	154	Size of
8 1/4	1080	pulled	
6 5/8	1665	1665	Depth set
5 3/16	2279	2279	
3			Perf. top
2	2503	2503	Perf. bottom
Liners Used			Perf. top
			Perf. bottom

CASING CEMENTED NOT SIZE _____ No. Ft. _____ Date _____

COAL WAS ENCOUNTERED AT 75 FEET 60 INCHES
115 FEET 36 INCHES FEET _____ INCHES
 FEET _____ INCHES FEET _____ INCHES

Formation	Color	Hard or Soft	Top	Bottom	Oil, Gas or Water	Depth Found	Remarks
Native Coal			75	80	6		
Pgh. Coal			115	118			
Big Dunkard			630	680			
Gas Sand			770	790			
First Salt			855	916			
2'nd Salt			932	972			
Maxon			1510	1640			
Big Lime			1640	1675			
Big Injun			1675	1765			
Gantz			1945	1984			
Fifty Ft.			2042	2065			
Thirty Ft.			2207	2225	Gas	2210	
Gordon Stray			2230	2247			
Gordon			2252	2319			
Fifth			2444	2459	Gas	2446-52	
Total Depth				2503			

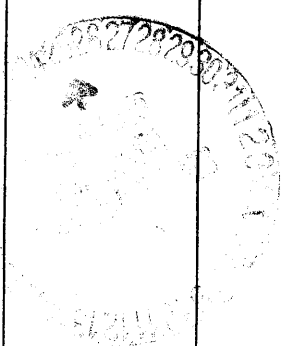

Formation	Color	Hard or Soft	Top	Bottom	Oil, Gas or Water	Depth Found	Remarks

Date March 24, 1949

APPROVED Hope Natural Gas Company, Owner

By _____ (Title)

E. G. OLDAKER NO. 8130 WELL.

1320A

Union District, Harrison County, W. Va.

By Hope Natural Gas Co., 445 W. Main St., Clarksburg, W. Va.

Abandoned under permit Har-.....-A?

On 110 acres.

Elevation, 1119' L.

Drilling commenced June 25, 1918; completed Aug. 26, 1918.

No water recorded.

10" casing, 154'; 8 $\frac{1}{2}$ "², 1080' (pulled); 6 $\frac{3}{8}$ "², 1665'; 5 $\frac{3}{16}$ "², 2279'; 2" tubing, 2503'.

Casing not cemented.

Coal was encountered at 75-80 and 115-118'.

Gas well. Abandonment reported to Dept. of Mines March 24, 1949.

Record to RCF from Mrs. Griffith July 10, 1949. Old File No. 1139.

	Top.	Bottom.
Native coal	75	- 80
Pittsburgh Coal	115	- 118
Big Dunkard Sand	630	- 680
Gas Sand	770	- 790
First Salt Sand	855	- 916
2nd Salt Sand	932	- 972
Martens Sand	1510	- 1640
Big Lime	1640	- 1675
Big Injun Sand	1675	- 1765
Gents Sand	1945	- 1984
Fifty-foot Sand	2042	- 2065
Thirty-foot Sand (gas, 2210')	2207	- 2225
Gordon Stray Sand	2230	- 2247
Gordon Sand	2252	- 2319
Fifth Sand (gas, 2446-52')	2444	- 2459
Total depth		2503