

Being a tract of 70 ac. partitioned from the Estate of J. T. Goodwin, dec.
 Surface owned by N.C. Goodwin, Route No. 2, Bristol, W. Va.
 Coal owned by W. Guy Tetrick, address Willis G. Tetrick, Jr., Clarksburg, W. Va.

New Location
 Drill Deeper
 Abandonment

South Penn Map N-39 S-8 E-5

Company ROHE CASING CO.
 Address Hamlin, W. Va.
 Farm J. T. Goodwin
 Tract Acres 154 3/4 Lease No.
 Well (Farm) No. Six Serial No.
 Elevation (Spirit Level) 1190'
 Quadrangle Centerpoint
 County Harrison District Tenmile
 Engineer M. H. Hest J.
 Engineer's Registration No. 1227
 File No. Drawing No.
 Date February, 1949 Scale 1" = 500'

STATE OF WEST VIRGINIA
 DEPARTMENT OF MINES
 OIL AND GAS DIVISION
 CHARLESTON

WELL LOCATION MAP
 FILE NO. HAR-1330-A

+ Denotes location of well on United States Topographic Maps, scale 1 to 62,500, latitude and longitude lines being represented by border lines as shown.

- Denotes one inch spaces on border line of original tracing.



STATE OF WEST VIRGINIA
DEPARTMENT OF MINES
OIL AND GAS DIVISION

1134

WELL RECORD

Permit No. 1330-A

Oil or Gas Well

(KIND)

Company South Penn Natural Gas Co.
Address Parkersburg, W. Va.
Farm J. T. Goodwin Acres 300
Location (waters) _____
Well No. 6 Elev. _____
District Tennile County Harrison
The surface of tract is owned in fee by _____
Address _____
Mineral rights are owned by _____
Address _____

Drilling commenced _____
Drilling completed Sept. 20, 1916
Date Shot _____ From _____ To _____
With _____


Open Flow /10ths Water in _____ Inch
/10ths Merc. in _____ Inch
Volume _____ Cu. Ft.
Rock Pressure _____ lbs. _____ hrs.
Oil ✓ _____ bbls., 1st 24 hrs.
Fresh water _____ feet _____ feet
Salt water _____ feet _____ feet

Casing and Tubing	Used in Drilling	Left in Well	Packers
Size			Kind of Packer
16			
13			
10		333	Size of
8 1/4		1510	
6 5/8		2285	Depth set
5 3/16		2953	
3			Perf. top
2			Perf. bottom
Liners Used			Perf. top
			Perf. bottom

CASING CEMENTED _____ SIZE _____ No. Ft. _____ Date _____

COAL WAS ENCOUNTERED AT _____ FEET _____ INCHES
_____ FEET _____ INCHES _____ FEET _____ INCHES
_____ FEET _____ INCHES _____ FEET _____ INCHES

Formation	Color	Hard or Soft	Top	Bottom	Oil, Gas or Water	Depth Found	Remarks
Native Coal			440	----			
Pgha Coal			984	990			
Dunkard Sand			1375	1435			
Salt Sand			1740	1760			
Maxon Sand			2140	2165			
Big Lime			2225	2270			
Big Injun			2270	2360			
Fifty Foot			2830	2855			
Thirty Foot			2934	2956			
Stray Sand			2980	3025			
Gordon Sand			3050	3073			
Gas & Oil			3052	----			
Oil			3052	----			
Total Depth				3073			
Initial Prod.							
Gordon Sand -- 12 bbls							
							Supt.

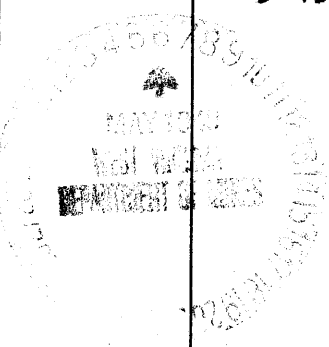

(Over)

J. T. GOODWIN NO. 6 WELL.

1330A

Tennile District, Harrison County, W. Va.

By South Penn Natural Gas Co., Parkersburg, W. Va.

Abandoned under permit Har-.....-A?

On 300 acres.

Elevation,' L.

Drilling completed Sept. 20, 1916.

Oil, 12 bbls., 1st 24 hrs.

10" casing, 333'; 8 $\frac{1}{2}$ "¹, 1510'; 6 $\frac{5}{8}$ "², 2285'; 5 $\frac{3}{8}$ "³, 2953'; all left in.

Torpedo record: 1916, with 30 qts., top, 2928'.

Oil well. Record to Dept. of Mines stamped May 6, 1949.

Record to RCT from Mrs. Griffith July 10, 1949. Old File No. 1134.

	Top.	Bottom.
Native coal	440	- ...
Pittsburgh Coal	984	- 990
Dunkard Sand	1375	- 1435
Salt Sand	1740	- 1760
Maxton Sand	2140	- 2165
Big Lime	2225	- 2270
Big Injun Sand	2270	- 2360
Fifty-foot Sand	2830	- 2855
Thirty-foot Sand	2934	- 2956
Stray Sand	2980	- 3025
Gordon Sand (gas and oil, 3052') (oil, 3052')	3050	- 3073
Total depth		3073