

Longitude 80° 20'

0.59 S
3.15 W

New Location
 Drill Deeper
 Abandonment

Map Sh 55 S15E12FB 512 P28

Company Hope Natural Gas Co.
 Address Clarksburg, W.Va.
 Farm Tabitha A. Pitts
 Tract _____ Acres 119 Lease No. 14005
 Well (Farm) No. _____ Serial No. 3637
 Elevation (Spirit Level) 1099'
 Quadrangle Weston
 County Harrison District Union
 Engineer W.M. Bowers
 Engineer's Registration No. 900
 File No. _____ Drawing No. _____
 Date 6-1-49 Scale 1" = 500'

STATE OF WEST VIRGINIA
 DEPARTMENT OF MINES
 OIL AND GAS DIVISION
 CHARLESTON

WELL LOCATION MAP
 FILE NO. HAR-1342-A

+ Denotes location of well on United States Topographic Maps, scale 1 to 62,500, latitude and longitude lines being represented by border lines as shown.

- Denotes one inch spaces on border line of original tracing.



STATE OF WEST VIRGINIA
DEPARTMENT OF MINES
OIL AND GAS DIVISION

1145

WELL RECORD

Permit No. AB 1342-A

Oil or Gas Well _____ (KIND)


Company Hope Natural Gas Company,
 Address 445 West Main St., Clarksburg, W. Va.
 Farm Tabitha A. Pitts Acres 119
 Location (waters) _____
 Well No. 3637 Elev. 1099
 District Union County Harrison
 The surface of tract is owned in fee by _____
 Address _____
 Mineral rights are owned by _____
 Address _____
 Drilling commenced August 14, 1914
 Drilling completed September 23, 1914
 Date Shot _____ From _____ To _____
 With _____

Casing and Tubing	Used in Drilling	Left in Well	Packers
Size			Kind of Packer
16			
13			
10	227	Pulled	Size of
8 3/4	904	Pulled	
6 5/8	1420	1420	Depth set
5 3/16	2000	2000	
3			Perf. top
2	3085	3085	Perf. bottom
Liners Used			Perf. top
			Perf. bottom

Open Flow _____ /10ths Water in _____ Inch
 _____ /10ths Merc. in _____ Inch
 Volume _____ Cu. Ft.
 Rock Pressure _____ lbs. _____ hrs.
 Oil _____ bbls., 1st 24 hrs.
 Fresh water none recorded feet _____ feet
 Salt water none recorded feet _____ feet

CASING CEMENTED NOT SIZE _____ No. Ft. _____ Date _____
 BELOW
 COAL WAS ENCOUNTERED AT _____ FEET _____ INCHES
 _____ FEET _____ INCHES FEET _____ INCHES
 _____ FEET _____ INCHES FEET _____ INCHES

Formation	Color	Hard or Soft	Top	Bottom	Oil, Gas or Water	Depth Found	Remarks
Big Dunkard			400	450			
Gas sand			459	515			
First Salt			710	825	show gas	790	
Second Salt			835	914	show gas	885	
Maxon			1244	1312			
Little Line			1330	1347			
Pencil cave			1347	1352			
Big Line			1352	1420			
Big Injun			1420	1548			
Squaw			1575	1612			
Berea			1670	1685			
Gants			1800	1812			
Fifty foot			1908	1930	show gas	1845	
Thirty foot			1941	1969	gas	1957	
Gordon stray			1992	2006			
Gordon			2018	2037			
Fourth			2161	2191			
Fifth			2328	2365	gas	2331 39	
Speechley			3024	3030	gas	3024	
Total depth				3071			

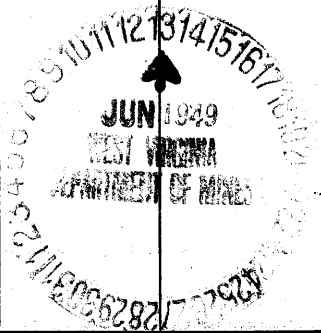


Formation	Color	Hard or Soft	Top	Bottom	Oil, Gas or Water	Depth Found	Remarks

Date June 9, 1949., 19

APPROVED Hope Natural Gas Company., Owner

By _____

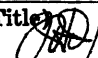(Title) 

TABITHA A. PITTS NO. 3637 WELL.

1342A

Union District, Harrison County, W. Va.
 By Hope Natural Gas Co., 445 W. Main St., Clarksburg, W. Va.
 Abandoned under permit No.-----A1
 On 119 acres.

Elevation, 1099' L.

Drilling commenced Aug. 10, 1914; completed Sept. 23, 1914.

No water recorded.

10" casing, 227' (pulled); 8 1/2", 904' (pulled); 6 3/4", 1420';
 5", 2000'; 2" tubing, 3085'.

Casing not cemented.

Gas well. Abandonment reported to Dept. of Mines June 9, 1949.

Record to RCT from Mrs. Griffith Aug. 10, 1949. Old File No. 1145.

	Top.	Bottom.
Big Dunkard Sand	400	450
Gas Sand	459	515
First Salt Sand (show gas, 790')	710	825
Second Salt Sand (show gas, 885')	875	914
Maxton Sand	1244	1312
Little Line	1330	1347
Pencil Cove	1347	1352
Big Line	1352	1420
Big Injun Sand	1420	1548
Squar Sand	1575	1612
Boran Sand	1670	1685
Gents Sand	1800	1812
Fifty-foot Sand (show gas, 1845') // // //	1906	1930
Thirty-foot Sand (gas, 1957')	1841	1969
Gordon Stray Sand	1992	2006
Gordon Sand	2018	2037
Fourth Sand	2161	2191
Fifth Sand (gas, 2331-39')	2328	2345
Speckley Sand (gas, 3024')	3024	3030
Total depth		3072