

Surface owned by Bruce Meredith, Salem, W. Va.
 Coal owned by W. Guy Tetrick, Clarksburg, W. Va.

New Location...
 Drill Deeper...
 Abandonment...

South Penn Map No. N-28 S-11, E-1

Company ROHE CASING CO.
 Address Hamlin, West Va.
 Farm Smith Varner
 Tract Acres 109.25 Lease No. _____
 Well (Farm) No. Two Serial No. _____
 Elevation (Spirit Level) 1315 **SC**
 Quadrangle Centerpoint
 County Harrison District Ten Mile
 Engineer W. S. Harbert
 Engineer's Registration No. 1227
 File No. _____ Drawing No. _____
 Date April, 1949 Scale 1" = 50 poles.

STATE OF WEST VIRGINIA
 DEPARTMENT OF MINES
 OIL AND GAS DIVISION
 CHARLESTON

WELL LOCATION MAP
 FILE NO. HAR-1343-A

+ Denotes location of well on United States Topographic Maps, scale 1 to 62,500, latitude and longitude lines being represented by border lines as shown.

- Denotes one inch spaces on border line of original tracing.



STATE OF WEST VIRGINIA
DEPARTMENT OF MINES
OIL AND GAS DIVISION

1146

WELL RECORD

Permit No. Ab 1343-A

Oil or Gas Well _____
(KIND)

Company South Penn Natural Gas Co.
Address Parkersburg, W. Va.
Farm Smith-Varner Acres 230
Location (waters) _____
Well No. 2 Elev. _____
District Tennile County Harrison
The surface of tract is owned in fee by _____
Address _____
Mineral rights are owned by _____
Address _____

Drilling commenced Jan. 10, 1901
Drilling completed _____
Date Shot _____ From _____ To _____
With _____
Open Flow _____ /10ths Water in _____ Inch
_____ /10ths Merc. in _____ Inch
Volume _____ Cu. Ft.
Rock Pressure _____ lbs. _____ hrs.
Oil _____ bbls., 1st 24 hrs.
Fresh water _____ feet _____ feet
Salt water _____ feet _____ feet


Casing and Tubing	Used in Drilling	Left in Well	Packers
Size			Kind of Packer
16			
13			
10		275	Size of
8 1/4		1550	
6 5/8		2469	Depth set
5 3/16		2647	
3			Perf. top
2			Perf. bottom
Liners Used			Perf. top
			Perf. bottom

CASING CEMENTED _____ SIZE _____ No. Ft. _____ Date _____
COAL WAS ENCOUNTERED AT _____ FEET _____ INCHES
_____ FEET _____ INCHES FEET _____ INCHES
_____ FEET _____ INCHES FEET _____ INCHES

Formation	Color	Hard or Soft	Top	Bottom	Oil, Gas or Water	Depth Found	Remarks
High Coal			1026	1032			
Dunkard Sand			1552	1635			
Maxon Sand			2200	2240			
Big Injun			2355	2452			
Fifty Foot			2985	3000			
Stray Sand			2967	3087			
Gordon Sand			3108	3118			
Gas			3071	3082			
Oil			3071	3082			
Total Depth				3118			
Initial Production							
Gordon -- No data							

TORPEDO RECORD
1903 -- 20 qts. -- Top 310
1906 -- 20 " -- Top 3110
1912 -- 60 " -- " 3110

Remarks: 120' - 4" X 4 1/2" F. J. Csg. Top-2990 Cave packer on top.

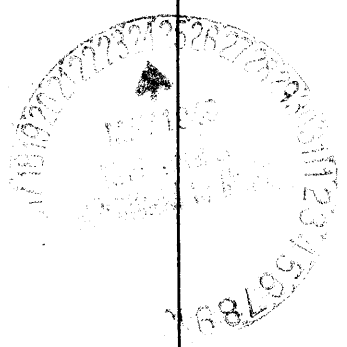

SMITH-VARNER NO. 2 WELL.

1343A

Tennile District, Harrison County, W. Va.
 By South Penn Natural Gas Co., Parkersburg, W. Va.
 Abandoned under permit Her-----Af

On 230 acres.

Elevation,' L.

Drilling completed Jan. 10, 1901.

Shot in 1903, with 20 qts., top, 3110'; in 1906, with 20 qts.,
 top, 3110'; in 1912, with 60 qts., top, 3110'.

Initial production, Gordon Sand, no data.

10" casing, 275'; 8 1/4", 1550'; 6 3/8", 2469'; 5 1/2", 2647'; all left in.

Remarks: 120', 4" x 4 1/2" F. J. Casing, top, 2990', cave packer on top.

Oil well. Record to Dept. of Mines stamped May 24, 1949.

Record to RCT from Mrs. Griffith Aug. 10, 1949. Old File No. 1146.

	Top.	Bottom.
Pittsburgh Coal	1026	- 1032
Dunkard Sand	1552	- 1635
Marton Sand	2200	- 2240
Big Injun Sand	2355	- 2452
Fifty-foot Sand	2985	- 3000
Stray Sand	2967	- 3087
Gordon Sand (gas, 3071-3082') (oil, 3071-3082')	3108	- 3118
Total depth		3118