


Scale 1" = 800 feet

Longitude 80° 15'

S. 43°
3.55'

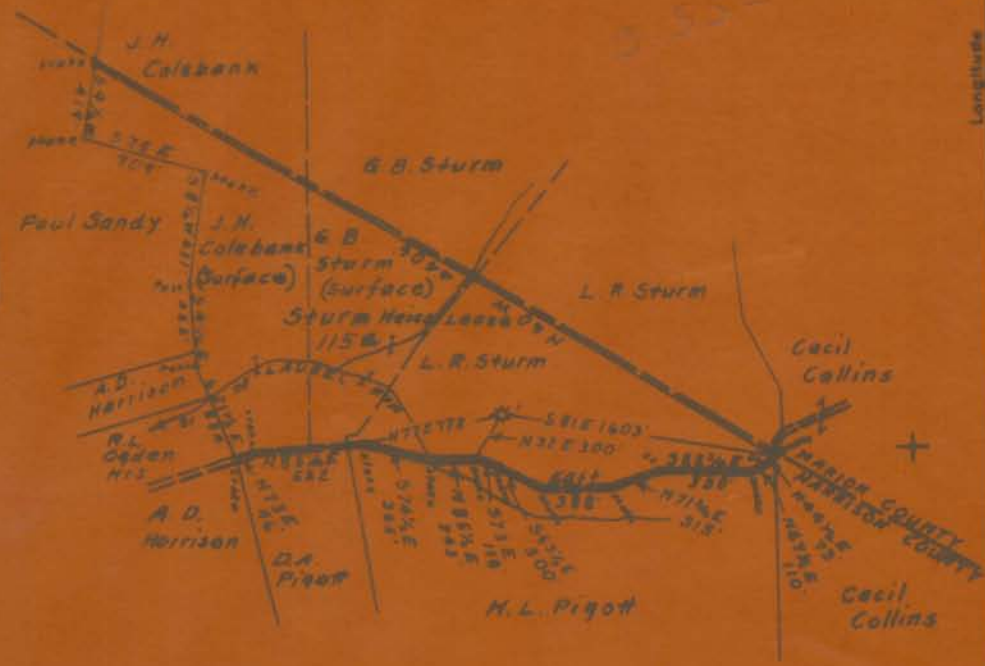

Surface & Coal owned by L.R. Sturm.
 Address: Mr. L. R. Sturm, P.O. Box No. 93, Enterprise, W. Va.
 Mail one blue print to Consolidation Coal Co. (W. Va.)
 % Mr. O. C. Ankrom, Watson Bldg. Room 800, Fairmont, W. Va.

- New Location
- Drill Deeper
- Abandonment

On 800 Map N41E. Sec 33 E20

Company	Road Supply Co.
Address	Salem, W. Va.
Farm	Sturm Heirs
Tract	Acres 115
Well (Farm) No.	1
Elevation (Spill Level)	Ground - 1051.74

STATE OF WEST VIRGINIA
 DEPARTMENT OF MINES
 OIL AND GAS DIVISION
 CHARLESTON

WELL LOCATION MAP
 FILE NO. HAR-1367-A

Scale 1" = 800 feet



Surface & Coal owned by L.R. Sturm.
 Address: Mr. L. R. Sturm, P.O. Box No. 93, Enterprise, W. Va.
 Mail one blue print to Consolidation Coal Co. (W. Va.)
 % Mr. O. C. Ankrom, Watson Bldg. Room 800, Fairmont, W. Va.

New Location
 Drill Casper
 Abandonment

On 800 Map N41E. Secs 33 E20.

STATE OF WEST VIRGINIA
DEPARTMENT OF MINES
OIL AND GAS DIVISION

WELL RECORD

Permit No. 111

Oil or Gas Well

Company Good Supply Company
Address 104 East Main St., Salem, W. Va.
Farm State Mine Acres 110
Location (waters) Sta. of Laurel Run
Well No. 1 Elev. 1081.74
District Clay County Harrison
The surface of tract is owned in fee by L. H. Sturm
Box 93 Address Enterprise, W. Va.
Mineral rights are owned by Same as surface
Address

Casing and Tubing	Used in Drilling	Left in Well	Packers
Size			
14			Kind of Packers
15	Cemented	Cemented	
16	95'	95'	Size of
24	1100'	1100'	
24	1506'	1506'	Depth sec.
2 1/2"			
3			Perf. top
2	1610'	1610'	Perf. bottom
Lines Used			Perf. top
			Perf. bottom

Drilling commenced _____
Drilling completed _____
Date Shot From _____ To _____
With _____
Open Flow /10ths Water in _____ Inch
/10ths Merc. in _____ Inch
Volume _____ Cu. Ft.
Rock Pressure _____ lbs. _____ hrs.
Oil _____ bbls. 1st 24 hrs.
Fresh water _____ feet _____ feet
Salt water _____ feet _____ feet

CASING CEMENTED SIZE 10" No. Ft. 95' Date

COAL WAS ENCOUNTERED AT 89 FEET 84 INCHES

FEET INCHES / FEET INCHES
FEET INCHES / FEET INCHES

Formation	Color	Hard or Soft	Top	Bottom	Oil, Gas or Water	Depth Found	Remarks
Pittsburgh Coal			82'	89'			
Big Dunkard			892	622			
Big Lime			1382	1475			
Big Injun			1508	1610			
Total Depth				1610			

STATE OF WEST VIRGINIA
DEPARTMENT OF MINES
OIL AND GAS DIVISION
INSPECTOR'S PLUGGING REPORT

Form No. 1

Well No.

COMPANY

ADDRESS

WELL NO.

CITY/TOWN

COUNTY

Being Mined in

Class	Quantity	Amount	Particulars	Location
MATERIALS AND SUPPLIES		BRIDGES		
CEMENT, PORTLAND		CONSTRUCTION		
WOOD		LOCATION		
LEAD		RECOVERED		
		SIZE		
		LOSS		

Driller's Name

Remarks



STATE OF MISSISSIPPI
DEPARTMENT OF MINES
OIL AND GAS DIVISION

INSPECTOR'S PLUGGING REPORT

Permit No. *Nov 136*

Well No. *1*

COMPANY *Good Supply Co*

Clay

FAIR *Stems. New*

WATER

Clay

Clay

Other Material Used

Date	Location	Amount	Type	Direction	PLUG USED AND DEPTH PLACED		BRIDGE	DEPTH AND FILING											
					CEMENT THICKNESS	WOOD SIZE		LEAD	CONCRETE TYPE	LOCATION	RECOVERED	SIZE	DEPT						

Drillers' Names

Remarks

Shot down

JAN 1911

1-1-11
DATE

I hereby certify I visited the above well on the day last

E. H. ...

CHIEF OF DIVISION