

GLEN EIK ADDITION
 To
 CLARKSBURG, W. VA
 Scale 1"=100'
 Plat In DB. 106 PB.

3.38 S
 0.49 W

New Location
 Drill Deeper
 Abandonment

Mapsh 44 S 12 E 15 D. B. 580 P 40.

Company Hope Natural Gas Co
 Address Clarksburg, W. Va.
 Farm Latstetter Heirs
 Tract _____ Acres Lots Lease No. 46323
 Well (Farm) No. _____ Serial No. 7608
 Elevation (Spirit Level) 943'
 Quadrangle Clarksburg SC
 County Harrison District Coal
 Engineer Wm Bowers
 Engineer's Registration No. 900
 File No. _____ Drawing No. _____
 Date 10-17-49 Scale 1"=40P

STATE OF WEST VIRGINIA
 DEPARTMENT OF MINES
 OIL AND GAS DIVISION
 CHARLESTON

WELL LOCATION MAP
 FILE NO. HAR-1369-A

+ Denotes location of well on United States Topographic Maps, scale 1 to 62,500, latitude and longitude lines being represented by border lines as shown.
 - Denotes one inch spaces on border line of original tracing.



STATE OF WEST VIRGINIA
DEPARTMENT OF MINES
OIL AND GAS DIVISION

1180

1369-A

WELL RECORD

Permit No. 1369-A Gas Well (KIND)


Company Hops Natural Gas Company.
Address 445 West Main St. Clarksburg, W. Va.
Farm Latstetter Mrs. Acres 104
Location (waters) _____
Well No. 7608 Elev. 943
District Coal County Harrison
The surface of tract is owned in fee by _____
Address _____
Mineral rights are owned by _____
Address _____
Drilling commenced Nov. 1, 1917
Drilling completed Dec. 20, 1917
Date Shot From _____ To _____
With _____
Open Flow /10ths Water in _____ Inch
/10ths Merc. in _____ Inch
Volume purchased well Cu. Ft.
Rock Pressure _____ lbs. _____ hrs.
Oil _____ bbls., 1st 24 hrs.
Fresh water no record feet _____ feet
Salt water none record feet _____ feet

Casing and Tubing	Used in Drilling	Left in Well	Packers
Size			Kind of Packer
16			
13			
10	175	175	Size of
8 3/4	823	823	
6 3/4	1257	1257	Depth set
5 3/16			
3			Perf. top
2	2343	2343	Perf. bottom
Liners Used			Perf. top
			Perf. bottom

CASING CEMENTED **NOT** SIZE No. Ft. _____ Date _____
COAL WAS ENCOUNTERED AT **BELOW** FEET _____ INCHES _____
FEET _____ INCHES FEET _____ INCHES
FEET _____ INCHES FEET _____ INCHES

Formation	Color	Hard or Soft	Top	Bottom	Oil, Gas or Water	Depth Found	Remarks
Little Dunkard			7	340			
Big Dunkard			371	422			
Gas sand			478	533			
First Salt			590	684			
Second Salt			732	860			
Maxon			1160	1188			
Little Lims			1213	1234			
Pencil cave			1234	1251			
B, g Lims			1251	1332			
Big Injun			1334	1452			
Fifty foot			1855 5	1892	gas	1861 64	
Gordon stray			2054	2118			
Gordon			2138	2182			
Fourth			2214	2232			
Fifth			2280	2318	gas	2288 2307	
Total depth				2343			

Formation	Color	Hard or Soft	Top	Bottom	Oil, Gas or Water	Depth Found	Remarks

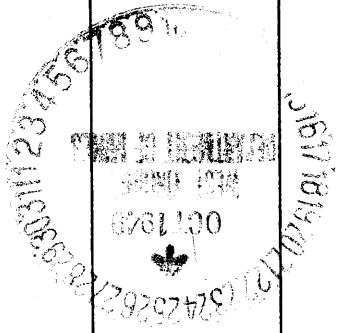

Date October 24, 1949., 19

APPROVED Hope Natural Gas Company., Owner

By _____

(Signature)