

New Location...   
 Drill Deeper...   
 Abandonment...

S 3.14  
 W 2.40

Map 544 S12R13 P042P33 FB746 P11

Company HOPE NATURAL GAS Co.  
 Address Clarksburg W.Va.  
 Farm James Cottrill  
 Tract \_\_\_\_\_ Acres 13 Lease No. 44528  
 Well (Farm) No. 1 Serial No. 7280  
 Elevation (Spirit Level) 1070'  
 Quadrange Clarksburg SC  
 County Harrison District Coal  
 Engineer W.M. Bower  
 Engineer's Registration No. 900  
 File No. \_\_\_\_\_ Drawing No. \_\_\_\_\_  
 Date 12-2-44 Scale 1" = 1500'

STATE OF WEST VIRGINIA  
 DEPARTMENT OF MINES  
 OIL AND GAS DIVISION  
 CHARLESTON  
**WELL LOCATION MAP**  
 FILE NO. HARR-1385-3

+ Denotes location of well on United States Topographic Maps, scale 1 to 62,500, latitude and longitude lines being represented by border lines as shown.

- Denotes one inch (25.4 cm) border line of original tracing.



STATE OF WEST VIRGINIA  
DEPARTMENT OF MINES  
OIL AND GAS DIVISION

1177

Permit No. HAR-1385-A

WELL RECORD


~~Oil~~ or Gas Well \_\_\_\_\_ (KIND)

Company Hope Natural Gas Company.  
Address 445 West Main St. Clarksburg, W. Va.  
Farm James Cottrill Acres 13  
Location (waters) \_\_\_\_\_  
Well No. 7280 Elev. 1070  
District Coal County Harrison  
The surface of tract is owned in fee by \_\_\_\_\_  
Address \_\_\_\_\_  
Mineral rights are owned by \_\_\_\_\_  
Address \_\_\_\_\_  
Drilling commenced March 20, 1903  
Drilling completed May 1903  
Date Shot \_\_\_\_\_ From \_\_\_\_\_ To \_\_\_\_\_  
With \_\_\_\_\_  
Open Flow \_\_\_\_\_ /10ths Water in \_\_\_\_\_ Inch  
\_\_\_\_\_ /10ths Merc. in \_\_\_\_\_ Inch  
Volume \_\_\_\_\_ Cu. Ft.  
Rock Pressure \_\_\_\_\_ lbs. \_\_\_\_\_ hrs.  
Oil \_\_\_\_\_ bbls., 1st 24 hrs.  
Fresh water none recorded feet \_\_\_\_\_ feet  
Salt water none recorded feet \_\_\_\_\_ feet

Casing and Tubing	Used in Drilling	Left in Well	Packers
Size			
16			Kind of Packer
13			
10	130	Pulled	Size of
8 1/4	980	Pulled	
6	1395	1395	Depth set
5 3/16	1416	1416	
3			Perf. top
2			Perf. bottom
Liners Used			Perf. top
			Perf. bottom

**NOT**  
CASING CEMENTED \_\_\_\_\_ SIZE \_\_\_\_\_ No. Ft. \_\_\_\_\_ Date \_\_\_\_\_  
**Below coal**  
COAL WAS ENCOUNTERED AT \_\_\_\_\_ FEET \_\_\_\_\_ INCHES  
\_\_\_\_\_ FEET \_\_\_\_\_ INCHES \_\_\_\_\_ FEET \_\_\_\_\_ INCHES  
\_\_\_\_\_ FEET \_\_\_\_\_ INCHES \_\_\_\_\_ FEET \_\_\_\_\_ INCHES

Formation	Color	Hard or Soft	Top	Bottom	Oil, Gas or Water	Depth Found	Remarks
Little Dunkard			409	429			
Big Dunkard			500	530			
Salt sand			830	980			
Maxon			1056	1076			
Big Line			1350	1405			
Big Injun			1410	1505			
Gordon			2225	2245	gas	2230	
Fourth			2280	2295			
Fifth			2365	2375	gas	?	
Total depth				2395			

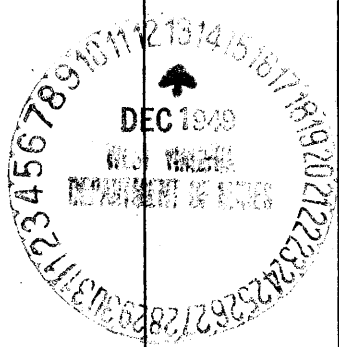


Formation	Color	Hard or Soft	Top	Bottom	Oil, Gas or Water	Depth Found	Remarks

Date December 12, 1949., 19\_\_

APPROVED Hope Natural Gas Company., Owner

By \_\_\_\_\_

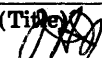(Title) 

JAMES COFFRILL NO. 7280 WELL.

1385A

Coal District, Harrison County, W. Va.  
 By Hope Natural Gas Co., 445 W. Main St., Clarksburg, W. Va.  
 Abandoned under permit Nos-..... -A?

On 13 acres.

Elevation, 1070' L.

Drilling commenced March 20, 1903; completed May 1903.

No water recorded.

10" casing, 130' (pulled); 8", 930' (pulled); 6", 1395'; 5", 1416'.

Casing not cemented.

Starts below coal.

Gas well. Record to Dept. of Mines dated Dec. 12, 1949.

Record to WOT from Mrs. Griffith Jan. 20, 1950. Old File No. 1177.

	Top.	Bottom.
Little Dunkard Sand	409	429
Big Dunkard Sand	500	530
Salt Sand	830	980
Horton Sand	1056	1076
Big Line	1350	1405
Big Injun Sand	1410	1505
Gordon Sand (gas, 2230')	2225	2285
Fourth Sand	2280	2295
Fifth Sand (gas,.....')	2365	2375
Total depth		2395