

New Location..
 Drill Deeper.....
 Abandonment.....

Map Sh. 55 S 19 E 9 FB. 953 P 24

Company	Hope Natural Gas Co.		
Address	Clarksburg, W. Va.		
Farm	G. W. Washburn		
Tract	Acres	Lease No.	52856
Well (Farm) No.		Serial No.	8068
Elevation (Spirit Level)	1020'		
Quadrangle	Weston		
County	Harrison	District	Union
Engineer	Wm Bowers		
Engineer's Registration No.	900		
File No.		Drawing No.	
Date	2-14-50		Scale 1" = 20P

STATE OF WEST VIRGINIA
 DEPARTMENT OF MINES
 OIL AND GAS DIVISION
 CHARLESTON

WELL LOCATION MAP
 FILE NO. HAR-1395-A

+ Denotes location of well on United States Topographic Maps, scale 1 to 62,500, latitude and longitude lines being represented by border lines as shown.

— Denotes one inch spaces on border line of original tracing.



STATE OF WEST VIRGINIA
DEPARTMENT OF MINES
OIL AND GAS DIVISION

1210

Permit No. HAR-1395A

WELL RECORD


Gas Well
(KIND)

Company Hope Natural Gas Company.
Address 445 West Main St. Clarksburg, W. Va.
Farm G.W. Washburn Acres 44
Location (waters) _____
Well No. 8066 Elev. 1020
District Union County Harrison
The surface of tract is owned in fee by _____
Address _____
Mineral rights are owned by _____
Address _____
Drilling commenced May 5, 1910
Drilling completed June 25, 1910
Date Shot _____ From _____ To _____
With _____
Open Flow _____ /10ths Water in _____ Inch
_____ /10ths Merc. in _____ Inch
Volume _____ Cu. Ft.
Rock Pressure _____ lbs. _____ hrs.
Oil _____ bbls., 1st 24 hrs.
Fresh water none recorded feet _____ feet
Salt water none recorded feet _____ feet

Casing and Tubing	Used in Drilling	Left in Well	Packers
Size			Kind of Packer
16			
13			
10	<u>407</u>	<u>Pulled</u>	Size of
8 3/4	<u>870</u>	<u>Pulled</u>	
6 5/8	<u>1270</u>	<u>1270</u>	Depth set
5 3/16	<u>1824</u>	<u>1824</u>	
3			Perf. top
2			Perf. bottom
Liners Used			Perf. top
			Perf. bottom

CASING CEMENTED NOT SIZE _____ No. Ft. _____ Date _____
COAL WAS ENCOUNTERED AT Below FEET _____ INCHES _____
FEET _____ INCHES FEET _____ INCHES
FEET _____ INCHES FEET _____ INCHES

Formation	Color	Hard or Soft	Top	Bottom	Oil, Gas or Water	Depth Found	Remarks
Little Dunkard			330	345			
Big Dunkard			400	425			
Gas Sand			530	580			
First Salt			630	722			
Second Salt			750	795			
Maxon			865	920			
Little Lime			1170	1190			
Pencil cave			1190	1215			
Big lime			1215	1275			
Big Injun			1275	1395			
Squaw			1400	1417			
Berea			1585	1621			
Ganta			1690	1710			
Fifty feet			1725	1745			
Thirty feet			1791	1825	gas	1792	
Gordon stray			1875	1925			
Gordog			1929	1985			
Fourth			2025	2050			
Fifth			2098	2115	gas	2099	
Speechley			2790	2798	gas	2793	
Total depth				2840			

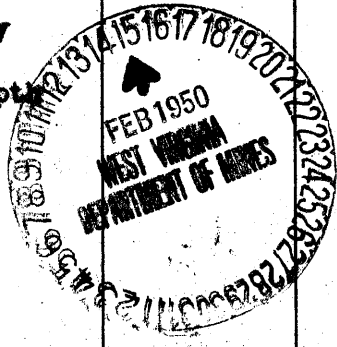

(Over) MAY 26 1950

Formation	Color	Hard or Soft	Top	Bottom	Oil, Gas or Water	Depth Found	Remarks

Date in February 8, 1950, 19_____

APPROVED Hope Natural Gas Company., Owner

By _____

(Title) [Signature]

G. W. WASHBURN NO. 8068 WELL.

1395A

Union District, Harrison County, W. Va.

By Hope Natural Gas Co., 445 W. Main St., Clarksburg, W. Va.

Abandoned under permit Har-.....-A?

On 44 acres.

Elevation, 1020' L.

Drilling commenced May 5, 1910; completed June 25, 1910.

No water recorded.

10" casing, 407' (pulled); 8 $\frac{1}{4}$ " , 370' (pulled); 6 $\frac{5}{8}$ " , 1270'; 5 $\frac{3}{16}$ " , 1824'.

Casing not cemented.

Starts below coal.

Gas well. Record to Dept. of Mines dated Feb. 8, 1950.

Record to RCT from Mrs. Griffith May 26, 1950. Old File No. 1210.

	Top.	Bottom.
Little Dunkard Sand	330	- 345
Big Dunkard Sand	400	- 425
Gas Sand	530	- 580
First Salt Sand	630	- 722
Second Salt Sand	750	- 795
Maxton Sand	865	- 920
Little Lime	1170	- 1190
Pencil Cave	1190	- 1215
Big Lime	1215	- 1275
Big Injun Sand	1275	- 1395
Squaw Sand	1400	- 1417
Berea Sand	1585	- 1621
Gantz Sand	1690	- 1710
Fifty-foot Sand	1725	- 1745
Thirty-foot Sand (gas, 1792')	1791	- 1825
Gordon Stray Sand	1875	- 1925
Gordon Sand	1929	- 1985
Fourth Sand	2025	- 2050
Fifth Sand (gas, 2099')	2098	- 2115
Speechley Sand (gas, 2793')	2790	- 2798
Total depth		2840