

New Location...
 Drill Deeper...
 Abandonment...

Map Sh. 44 S11E10 FB949 P25

S 2.16
 W 0.68

Company Hope Natural Gas Co.
 Address Clarksburg, W. Va.
 Farm Humphries - Hurst
 Tract _____ Acres 164 Lease No. 52701 & 52700
 Well (Farm) No. _____ Serial No. 7962
 Elevation (Spirit Level) 1086
 Quadrangle Clarksburg
 County Harrison District Coal SW
 Engineer W.M. Bowers
 Engineer's Registration No. 900
 File No. _____ Drawing No. _____
 Date 2-13-50 Scale 1" = 40 Poles

STATE OF WEST VIRGINIA
 DEPARTMENT OF MINES
 OIL AND GAS DIVISION
 CHARLESTON

WELL LOCATION MAP
 FILE NO. HAR-1397-A

+ Denotes location of well on United States Topographic Maps, scale 1 to 62,500, latitude and longitude lines being represented by border lines as shown.

- Denotes one inch spaces on border line of original tracing.



STATE OF WEST VIRGINIA
DEPARTMENT OF MINES
OIL AND GAS DIVISION

1207

Permit No. HAR-1397-A


~~Water~~ Gas Well (KIND)

Company Hope Natural Gas Company.
Address 445 West Main St. Clarksburg, W. Va.
Farm Humphries Hurst Acres 164
Location (waters) _____
Well No. 7962 Elev. 1086
District Coal County Harrison
The surface of tract is owned in fee by _____
Address _____
Mineral rights are owned by _____
Address _____
Drilling commenced July 31, 1908
Drilling completed Nov. 5, 1908
Date Shot From _____ To _____
With _____
Open Flow _____ /10ths Water in _____ Inch
_____ /10ths Merc. in _____ Inch
Volume _____ Cu. Ft.
Rock Pressure _____ lbs. _____ hrs.
Oil _____ bbls., 1st 24 hrs.
Fresh water none recorded feet _____ feet
Salt water none recorded feet _____ feet

Casing and Tubing	Used in Drilling	Left in Well	Packers
Size			Kind of Packer
16			
13			
10	<u>315</u>	<u>Pulled</u>	Size of
8 1/2	<u>1063</u>	<u>Pulled</u>	
6%	<u>1557</u>	<u>1557</u>	Depth set
5 3/16	<u>2021</u>	<u>2021</u>	
3			Perf. top
2	<u>2430</u>	<u>2430</u>	Perf. bottom
Liners Used			Perf. top
			Perf. bottom

CASING CEMENTED NOT SIZE _____ No. Ft. _____ Date _____
BELOW
COAL WAS ENCOUNTERED AT _____ FEET _____ INCHES
_____ FEET _____ INCHES FEET _____ INCHES
_____ FEET _____ INCHES FEET _____ INCHES

Formation	Color	Hard or Soft	Top	Bottom	Oil, Gas or Water	Depth Found	Remarks
Big Dunkard			515	566			
Gas sand			701	720			
First Salt			830	865			
Second Salt			934	1060			
Little Lime							
Pencil cave			1385	1391			
Big Lime			1391	1455			
Big Injun			1465	1555	gas	1552	
Squaw			1560	1580			
Fifty feet			1870	1925			
Thirty feet			1980	2008	gas	1982	
Gordon stray			2012	2040			
Gordon			2065	2075	gas	2065	
Fourth			2258	2273			
Fifth			2393	2396	gas	2394	
Drilled to				2637			
Filled back to				2430			

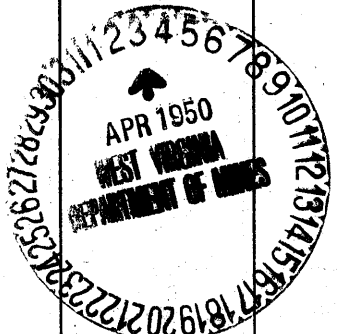

(Over)

MAY 26 1950

