

S 3.44
W 0.68

New Location...
 Drill Deeper...
 Abandonment... Partial

Map Sh. 58 S 18 E 6 FB 537 P. 19-20.

Company Hope Natural Gas Co
 Address Clarksburg, W. Va.
 Farm Jennie Matheny
 Tract _____ Acres 130 Lease No. 31808
 Well (Farm) No. _____ Serial No. 4352
 Elevation (Spirit Level) 1136'
 Quadrangle Vadis **NE**
 County Harrison District Union
 Engineer W.M. Powers
 Engineer's Registration No. 900
 File No. _____ Drawing No. _____
 Date 11-10-50 Scale 1"=40P

STATE OF WEST VIRGINIA
 DEPARTMENT OF MINES
 OIL AND GAS DIVISION
 CHARLESTON

WELL LOCATION MAP
 FILE NO. HAR-1441-A

+ Denotes location of well on United States Topographic Maps, scale 1 to 62,500, latitude and longitude lines being represented by border lines as shown.

- Denotes one inch spaces on border line of original tracing.



STATE OF WEST VIRGINIA
DEPARTMENT OF MINES
OIL AND GAS DIVISION

1259

Ad 1741-A

WELL RECORD

Permit No. _____ EDGE Gas Well _____ (KIND)


Company Hope Natural Gas Company.
 Address 445 West Main St. Clarksburg, W. Va.
 Farm Jennie Matheny Acres 130
 Location (waters) _____
 Well No. 4352 Elev. 1136
 District Union County Harrison
 The surface of tract is owned in fee by _____
 Address _____
 Mineral rights are owned by _____
 Address _____
 Drilling commenced June 30, 1916
 Drilling completed August 10, 1916
 Date Shot _____ From _____ To _____
 With _____
 Open Flow _____ /10ths Water in _____ Inch
 _____ /10ths Merc. in _____ Inch
 Volume _____ Cu. Ft.
 Rock Pressure _____ lbs. _____ hrs.
 Oil _____ bbls., 1st 24 hrs.
 Fresh water none recorded feet _____ feet
 Salt water none recorded feet _____ feet

Casing and Tubing	Used in Drilling	Left in Well	Packers
Size			
16			Kind of Packer
13			
10	155	Pulled	Size of
8 1/4	1301	1301	
6 5/8	1791	1791	Depth set
5 3/16	2401	2401	
3			Perf. top
2			Perf. bottom
Liners Used			Perf. top
			Perf. bottom

CASING CEMENTED _____ NOT _____ SIZE _____ No. Ft. _____ Date _____

COAL WAS ENCOUNTERED AT 300 FEET 48 INCHES
 _____ FEET _____ INCHES _____ FEET _____ INCHES
 _____ FEET _____ INCHES _____ FEET _____ INCHES

Formation	Color	Hard or Soft	Top	Bottom	Oil, Gas or Water	Depth Found	Remarks
Pittsburgh Coal			300	304			
Little Dunkard			690	723			
Big Dunkard			760	790			
Gas sand			890	930			
First Salt			1020	1120			
Second Salt			1140	1275			
Little Lime			1725	1740			
Pencil Cave			1740	1750			
Big Lime			1750	1790			
Big Injun			1790	1902			
Gantz			2103	2158			
Fifty foot			2218	2238			
Thirty foot			2336	2380	gas	2338	
Gordon stray			2390	2432			
Gordon			2436	2475	gas	2448	
Total depth				2475			

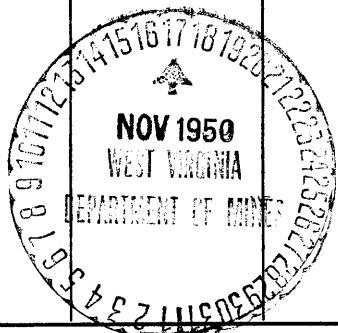

(Over) JUN 24 1951

Formation	Color	Hard or Soft	Top	Bottom	Oil, Gas or Water	Depth Found	Remarks

Date November 15, 1950., 19____

APPROVED Hope Natural Gas Company., Owner

By _____

(Title)
[Signature]