

New Location   
 Drill Deeper   
 Abandonment

8123  
 F.B. 725 P. 29

MAR 28 1952

MAP 55 SIDE 9

Company HOPE NATURAL GAS CO.  
 Address CLARKSBURG W.VA.  
 Farm JACOB P. POST  
 Tract Acres 283 Lease No. 52902  
 Well (Farm) No. 1-2-3-4 Serial No. 8121-8123  
 Elevation (Spirit Level) 8121 = 1001 8122 = 977 8123 = 1097 8124 = 1047  
 Quadrangle WESTON  
 County HARRISON District UNION  
 Engineer Wm Bowers  
 Engineer's Registration No. 900  
 File No. \_\_\_\_\_ Drawing No. \_\_\_\_\_  
 Date 6-17-49 Scale 1" = 40 P.

STATE OF WEST VIRGINIA  
 DEPARTMENT OF MINES  
 OIL AND GAS DIVISION  
 CHARLESTON

WELL LOCATION MAP

FILE NO. HAR-1357-A-#8123  
HAR-1459-A-#8124

+ Denotes location of well on United States Topographic Maps, scale 1 to 62,500, latitude and longitude lines being represented by border lines as shown.

- Denotes one inch spaces on border line of original tracing.

J.S.



STATE OF WEST VIRGINIA  
DEPARTMENT OF MINES  
OIL AND GAS DIVISION

1260

WELL RECORD

Oil or Gas Well (KIND)

Permit No. HAR-1459-A

Company Hope Natural Gas Company.  
Address 445 West Main St. Clarksburg, W. Va.  
Farm Jacob P. Post Acres 283  
Location (waters) \_\_\_\_\_  
Well No. 9124 Elev. 1047  
District Non County Harrison  
The surface of tract is owned in fee by \_\_\_\_\_  
Address \_\_\_\_\_  
Mineral rights are owned by \_\_\_\_\_  
Address \_\_\_\_\_  
Drilling commenced October 15, 1917  
Drilling completed November 15, 1917  
Date Shot \_\_\_\_\_ From \_\_\_\_\_ To \_\_\_\_\_  
With \_\_\_\_\_


Open Flow \_\_\_\_\_ /10ths Water in \_\_\_\_\_ Inch  
\_\_\_\_\_ /10ths Merc. in \_\_\_\_\_ Inch  
Volume \_\_\_\_\_ Cu. Ft.  
Rock Pressure \_\_\_\_\_ lbs. \_\_\_\_\_ hrs.  
Oil \_\_\_\_\_ bbls., 1st 24 hrs.  
Fresh water none recorded feet \_\_\_\_\_ feet  
Salt water none recorded feet \_\_\_\_\_ feet

Casing and Tubing	Used in Drilling	Left in Well	Packers
Size			Kind of Packer
16			
13			
10	107	Pulled	Size of
8 1/4	843	226	
6 5/8	1372	1372	Depth set
5 3/16			
3			Perf. top
2	2235		Perf. bottom
Liners Used			Perf. top
			Perf. bottom

CASING CEMENTED Not SIZE \_\_\_\_\_ No. Ft. \_\_\_\_\_ Date \_\_\_\_\_

COAL WAS ENCOUNTERED AT BELOW FEET \_\_\_\_\_ INCHES \_\_\_\_\_  
FEET \_\_\_\_\_ INCHES \_\_\_\_\_ FEET \_\_\_\_\_ INCHES \_\_\_\_\_  
FEET \_\_\_\_\_ INCHES \_\_\_\_\_ FEET \_\_\_\_\_ INCHES \_\_\_\_\_

Formation	Color	Hard or Soft	Top	Bottom	Oil, Gas or Water	Depth Found	Remarks
Little Dunkard			312	345			
Big Dunkard			380	438			
Gas sand			486	522			
First Salt			608	670			
Second Salt			718	798			
Third Salt			830	912			
Maxon			1080	1140			
Little Lime			1284	1300			
Pencil cave			1300	1308			
Big Lime			1308	1372			
Big Injun			1372	1504			
Berea			1670	1700			
Gantz			1780	1795	gas	1782	
Fifty foot			1817	1840			
Thirty foot			1858	1884	gas	1869	
Gordon stray			1974	2006			
Gordon			2014	2054			
Fourth			2117	2129			
Fifth			2182	2197	gas	2184 2189	
Total depth				2229			

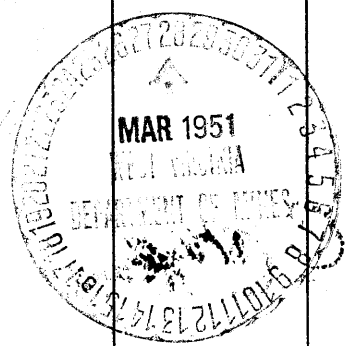

(Over) JUN 24 1951

Formation	Color	Hard or Soft	Top	Bottom	Oil, Gas or Water	Depth Found	Remarks

Date **March 26, 1951.**

\_\_\_\_\_, 19\_\_\_\_

**Hope Natural Gas Company.**

APPROVED \_\_\_\_\_, Owner

By \_\_\_\_\_

(Title)

*[Signature]*

JACOB P. POST NO. 8124 WELL.

1459A

Union District, Harrison County, W. Va.

By Hope Natural Gas Co., 445 W. Main St., Clarksburg, W. Va.

Abandoned under permit No. ....-AT

On 283 acres.

Elevation, 1047' L.

Drilling commenced Oct. 15, 1917; completed Nov. 15, 1917.

No water recorded.

10" casing, 107' (jacket); 8", 840' (226' ~~1000-17~~); 6", 1372';  
2" tubing, 2225'.

Casing not cemented.

Starts below coal.

Gas well. Record to Dept. of Mines dated March 26, 1951.

Record to ROT from Mrs. Griffith June 24, 1951. Old File No. 1260.

	Top.	Bottom.
Little Dunkard Sand	312	- 345
Big Dunkard Sand	380	- 438
Gas Sand	486	- 522
First Salt Sand	608	- 670
Second Salt Sand	718	- 798
Third Salt Sand	830	- 912
Nexton Sand	1080	- 1140
Little Lime	1284	- 1300
Pencil Cove	1300	- 1308
Big Lime	1308	- 1372
Big Lajun Sand	1372	- 1504
Berea Sand	1670	- 1700
Geats Sand (gas, 1782')	1780	- 1795
Fifty-foot Sand	1817	- 1840
Thirty-foot Sand (gas, 1869')	1858	- 1884
Gordon Stray Sand	1974	- 2006
Gordon Sand	2014	- 2054
Fourth Sand	2117	- 2129
Fifth Sand (gas, 2184, 2189')	2182	- 2197
Total depth		2229