

Tract of 60 1/2 Ac conveyed by Granville Knight, et ux, to W B Maxwell by deed dated May 22, 1880, and recorded in Deed Book No 62, page 477

RUSSELL LEE RIFFLE 38 1/2 Ac.  
 (Tract conveyed by Alden Sidebottom, et ux, by deed dated Feb. 16, 1950, and recorded in the office of the Clerk of the County Court of Harrison Co. in Deed Book 685, p 20)

Handwritten notes and measurements:  
 1.16S 2.40W  
 1.17S 2.26W  
 0.94S 2.32W  
 1.12S 2.40W  
 2.42W  
 1.18W  
 2.35W  
 0.95W  
 2.04W  
 612W

MAR 12 1952  
 MAR 28 1952

All wells are below the outcrop of both the Redstone and Pittsburg coal. Coal leased for stripping to the Keeley Construction Co. and surface are owned by Frank Maxwell whose postoffice address is Clarksburg, W. Va.

New Location   
 Drill Deeper   
 Abandonment

Company **VALLEY STEEL PRODUCTS CO.**  
 Address **St. Louis, Mo.**  
 Farm **W. Brent Maxwell**  
 Tract \_\_\_\_\_ Acres **1300** Lease No. \_\_\_\_\_  
 Well (Farm) No. **14, 22, 33, 38** Serial No. **No 38 = 1105**  
 Elevation (Spirit Level) **No 14 = 1030, No 22 = 1134, No 33 = 1095**  
 Quadrangle **Weston** **NC**  
 County **Harrison** District **Union**  
 Engineer **W. S. Hoyle**  
 Engineer's Registration No. **1227**  
 File No. \_\_\_\_\_ Drawing No. \_\_\_\_\_  
 Date **October, 1951** Scale **1" = 500'**

STATE OF WEST VIRGINIA  
 DEPARTMENT OF MINES  
 OIL AND GAS DIVISION  
 CHARLESTON

**WELL LOCATION MAP**  
 FILE NO. **HAR-1507-A-#14**  
**HAR-1508-A-#22**  
**HAR-1510-A-#33**  
**HAR-1512-A-#38**

+ Denotes location of well on United States Topographic Maps, scale 1 to 62,500, latitude and longitude lines being represented by border lines as shown.  
 - Denotes one inch spaces on border line of original tracing.

W. BRENT MAXWELL NO. 38 WELL.

1512A

Union District, Harrison County, W. Va.  
 By Valley Steel Products Co., St. Louis, Mo.  
 Abandoned under permit Har-.....-A?  
 On 1300 acres, on West Fork River.  
 Elevation, 1105' L.

Surface owned by Frank Maxwell, Clarksburg, W. Va.  
 Casing record not given.

Oil and gas well. Record to Dept. of Mines stamped Oct. 29, 1951.  
 Record to RCT from Mrs. Griffith Dec. 2, 1951. O.F.No.1424.

	Top.	Bottom.
Little Dunkard Sand	365	- 372
Big Dunkard Sand	430	- 490
Gas Sand	552	- 602
First Salt Sand	685	- 765
Second Salt Sand (water, 919-932')	970	- 975
Little Lime	1360	- 1375
Pencil Cave	1375	- 1394
Big Lime	1394	- 1452
Big Injun Sand	1452	- 1570
Gantz Sand	1865	- 1878
Fifty-foot Sand	1900	- 1997
Thirty-foot Sand	2019	- 2042
Gordon Stray Sand	2060	- 2215
Gordon Sand (oil, 2226-2229') (oil, 2231-2233') (gas, 2231')	2223	- ....
Total depth		2243



STATE OF WEST VIRGINIA  
DEPARTMENT OF MINES  
OIL AND GAS DIVISION

1474

Plot 1504-A

1512-A

WELL RECORD


Permit No. 1512-A Oil or Gas Well \_\_\_\_\_ (KIND)

Company Valley Steel Products Co.  
 Address St. Louis, Mo.  
 Farm W. Brent Maxwell Acres 1300  
 Location (waters) West Fork River  
 Well No. 38 Elev. 1105  
 District Union County Harrison  
 The surface of tract is owned in fee by Frank Maxwell  
 Address Clarkeburg, Va.  
 Mineral rights are owned by \_\_\_\_\_  
 Address \_\_\_\_\_  
 Drilling commenced \_\_\_\_\_  
 Drilling completed \_\_\_\_\_  
 Date Shot \_\_\_\_\_ From \_\_\_\_\_ To \_\_\_\_\_  
 With \_\_\_\_\_  
 Open Flow \_\_\_\_\_ /10ths Water in \_\_\_\_\_ Inch  
 \_\_\_\_\_ /10ths Merc. in \_\_\_\_\_ Inch  
 Volume \_\_\_\_\_ Cu. Ft.  
 Rock Pressure \_\_\_\_\_ lbs. \_\_\_\_\_ hrs.  
 Oil \_\_\_\_\_ bbls., 1st 24 hrs.  
 Fresh water \_\_\_\_\_ feet \_\_\_\_\_ feet  
 Salt water \_\_\_\_\_ feet \_\_\_\_\_ feet

Casing and Tubing	Used in Drilling	Left in Well	Packers
Size			
16			Kind of Packer _____
18			
10			Size of _____
8 1/4			
6 1/2			Depth set _____
5 3/16			
3			Perf. top _____
2			Perf. bottom _____
Liners Used			Perf. top _____
			Perf. bottom _____

CASING CEMENTED \_\_\_\_\_ SIZE \_\_\_\_\_ No. Ft. \_\_\_\_\_ Date \_\_\_\_\_  
 COAL WAS ENCOUNTERED AT \_\_\_\_\_ FEET \_\_\_\_\_ INCHES  
 \_\_\_\_\_ FEET \_\_\_\_\_ INCHES FEET \_\_\_\_\_ INCHES  
 \_\_\_\_\_ FEET \_\_\_\_\_ INCHES FEET \_\_\_\_\_ INCHES

Formation	Color	Hard or Soft	Top	Bottom	Oil, Gas or Water	Depth Found	Remarks
Pittsburgh Coal							
Little Dunkard			365	372			
Big Dunkard			430	490			
Gas Sand			552	602			
First Salt			685	765			
Second Salt			970	975			
Water			917	932			
Maxon							
Little Lime			1360	1375			
Pencil Cave			1375	1394			
Big Lime			1394	1452			
Big Injun			1452	1570			
Squaw							
Berea							
Gantz			1865	1873			
Fifty Foot			1900	1997			
Thirty Foot			2019	2042			
Gordon Stray			2060	2215			
Gordon			2223				
Oil			2220	2229			
			2231	2233			
Gas			2231				
Fourth							
Fifth							
Speechly							
Total Depth				2243			

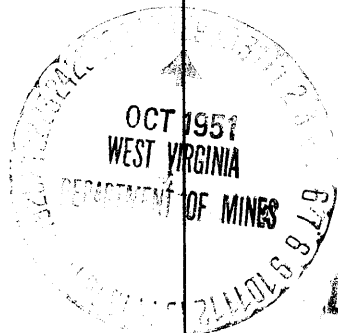

DEC 2 1952