


Latitude 39° 20'

Longitude 80° 20'

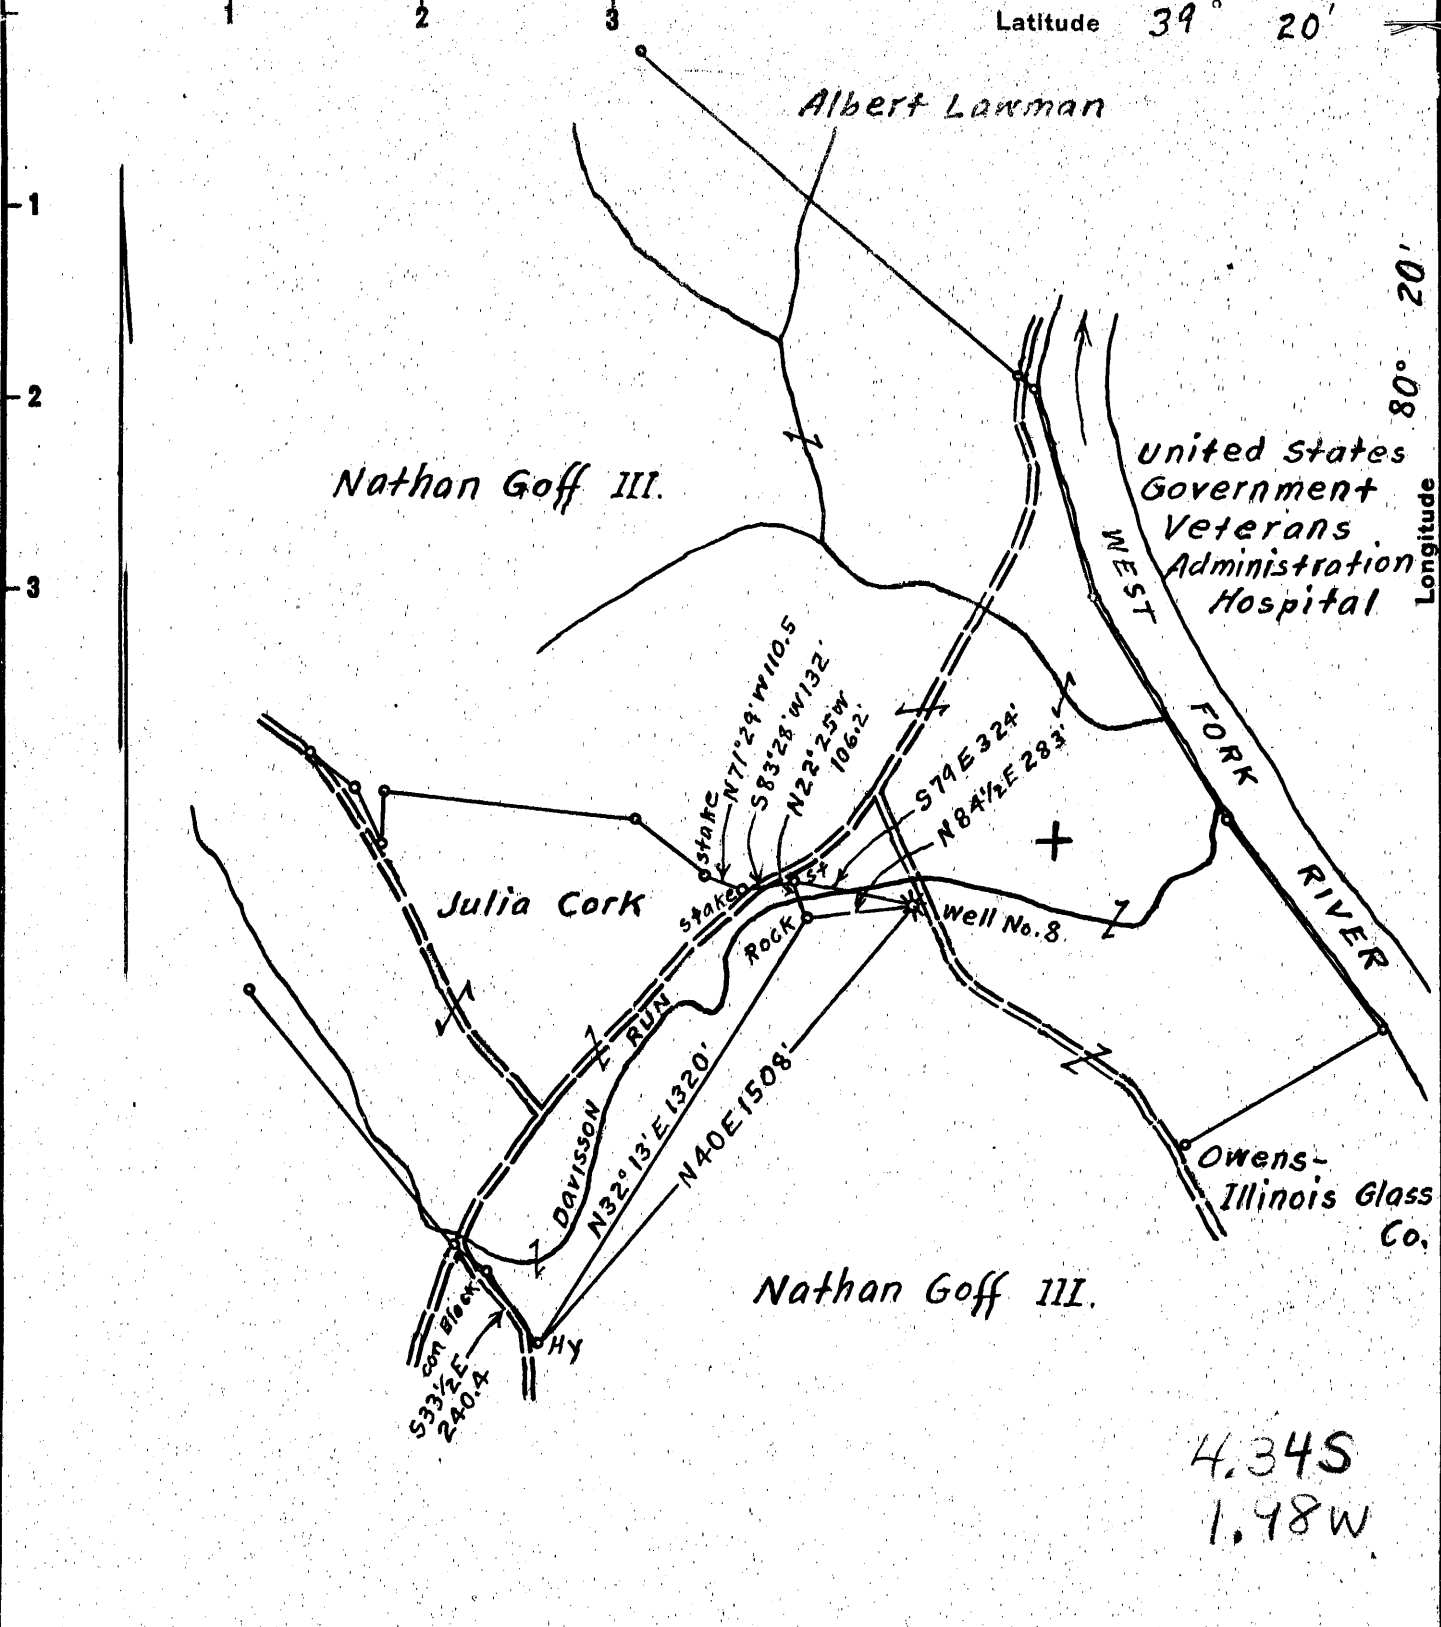

4.34S
1.48W

Surface owned by Nathan Goff III.
Address: Mr. Nathan Goff III. P.O. Box 707. Clarksburg, W. Va.
No Coal.

New Location
Drill Deeper
Abandonment ON 800' Map N20E Sqs. S 13 E 14.

Company William Moses
 Address Salem, W. Va.
 Farm Nathan Goff III.
 Tract _____ Acres 1087.24 Lease No. _____
 Well (Farm) No. 8. Serial No. _____
 Elevation (Spirit Level) Floor - 938.97
Ground - 936.07
 Quadrangle Clarksburg
 County Harrison District Clark
 Engineer Elsworth Haines
 Engineer's Registration No. 2221.
 File No. _____ Drawing No. _____
 Date Dec. 31st, 1953. Scale 1" = 500 Feet

STATE OF WEST VIRGINIA
DEPARTMENT OF MINES
OIL AND GAS DIVISION
CHARLESTON

WELL LOCATION MAP
FILE NO. HAR-1608-A

+ Denotes location of well on United States Topographic Maps, scale 1 to 62,500, latitude and longitude lines being represented by border lines as shown.
- Denotes one inch spaces on border line of original tracing.



STATE OF WEST VIRGINIA
DEPARTMENT OF MINES
OIL AND GAS DIVISION

WELL RECORD

1486

Permit No. 1602-A Oil or Gas Well Gas (KIND)

Company William Moses
 Address Salem, W. Va.
 Farm Nathan Goff III Acres 1087.841
 Location (waters) _____
 Well No. Right Elev. 936.07
 District Clark County Harrison
 The surface of tract is owned in fee by Nathan Goff, III
 Address Clarksburg, W. Va.
 Mineral rights are owned by No Coal
 Address _____
 Drilling commenced _____
 Drilling completed _____
 Date Shot _____ From _____ To _____
 With _____

Casing and Tubing	Used in Drilling	Left in Well	Packers
Size			Kind of Packer
16			
13			
10		166	Size of
8 1/4		783	
6 3/4		1346	Depth set
5 3/16			
3		1346	Perf. top
2			Perf. bottom
Liners Used			Perf. top
			Perf. bottom

Open Flow _____ /10ths Water in _____ Inch
 _____ /10ths Merc. in _____ Inch
 Volume _____ Cu. Ft.
 Rock Pressure _____ lbs. _____ hrs.
 Oil _____ bbls., 1st 24 hrs.
 Fresh water _____ feet _____ feet
 Salt water _____ feet _____ feet

CASING CEMENTED _____ SIZE _____ No. Ft. _____ Date _____

COAL WAS ENCOUNTERED AT No Coal FEET _____ INCHES _____
 FEET _____ INCHES FEET _____ INCHES
 FEET _____ INCHES FEET _____ INCHES

Formation	Color	Hard or Soft	Top	Bottom	Oil, Gas or Water	Depth Found	Remarks
L. Dunkard			180	220			
B. Dunkard			276	291			
1st Salt			518	620			
2nd "			628	786			
B. Injun			1260	1376			
Garden Sand			2040	2052			
Fourth Sand			2060	2090			
Fifth Sand			2191	2215			
Total Depth			2237				

