


Latitude 39° 15'

Longitude 80° 20'

1.74 S
3.73 W

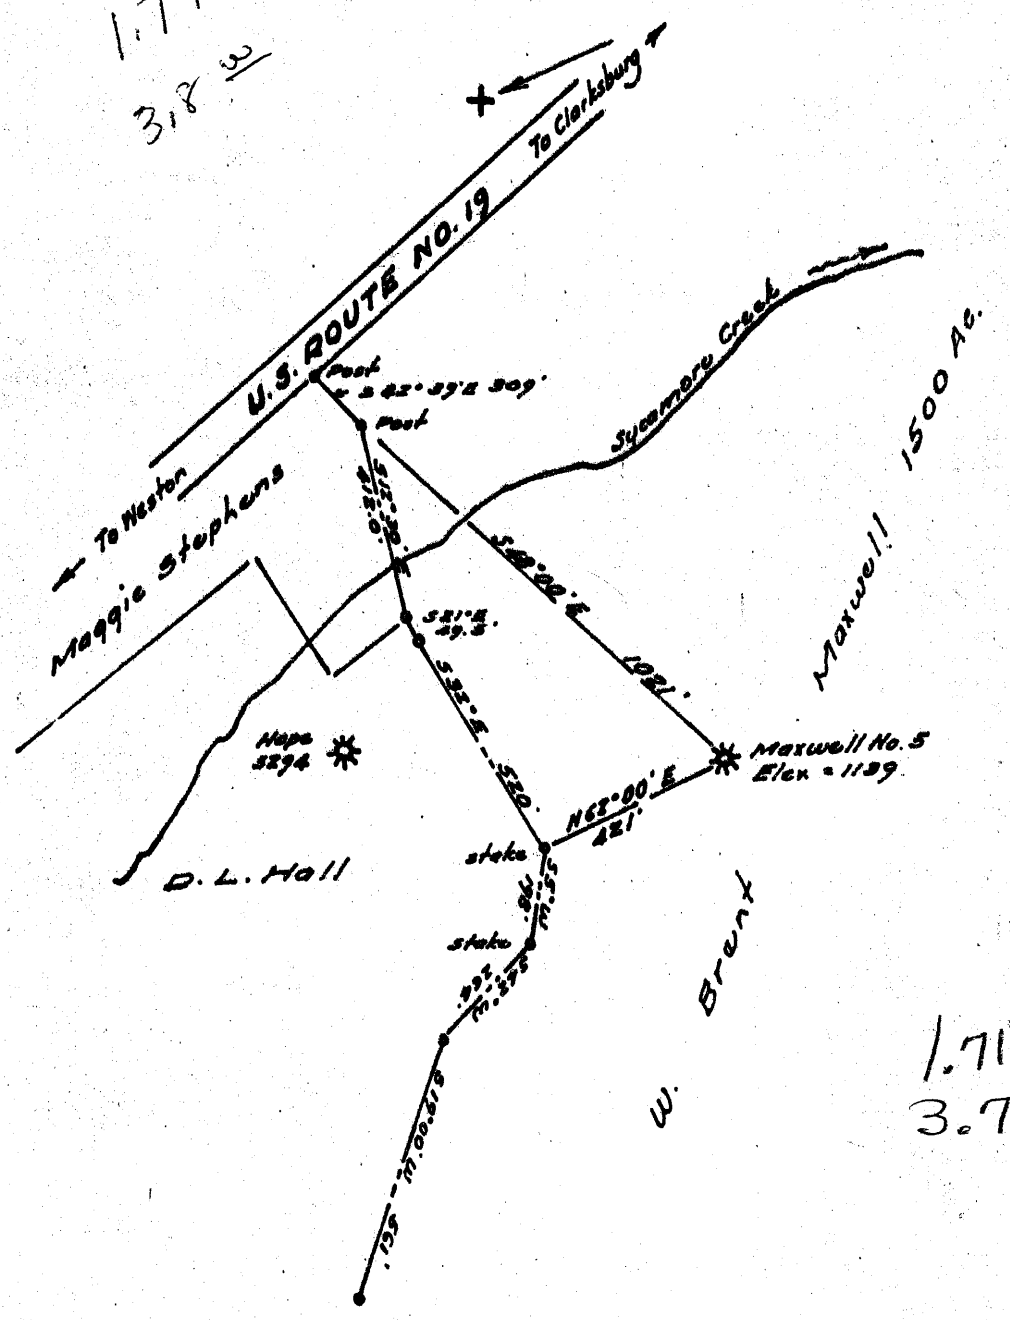

1.71 S
3.73 W

Surface owned by Mrs. Louis Henderson, Clarksburg, W. Va.
Well below outcrop of coal

- New Location..
- Drill Deeper.....
- Abandonment.....

Company DELEWARE GAS CO.
 Address Goff Bldg., Clarksburg, W. Va.
 Farm W. Brent Maxwell
 Tract _____ Acres 1500 Lease No. _____
 Well (Farm) No. Five Serial No. _____
 Elevation (Spirit Level) 1139
 Quadrangle Waston
 County Harrison District Union
 Engineer W. H. [Signature]
 Engineer's Registration No. 1227
 File No. _____ Drawing No. _____
 Date August, 1956 Scale 1" = 400'

STATE OF WEST VIRGINIA
DEPARTMENT OF MINES
OIL AND GAS DIVISION
CHARLESTON

WELL LOCATION MAP
FILE NO. HAR-1668-A

- + Denotes location of well on United States Topographic Maps, scale 1 to 62,500, latitude and longitude lines being represented by border lines as shown.
- Denotes one inch spaces on border line of original tracing.

STATE OF WEST VIRGINIA
DEPARTMENT OF MINES
OIL AND GAS DIVISION

A 246

WELL RECORD

Weston Prod
Ab 1668A
Permit No. _____


Oil or Gas Well Gas
(Kind)

Company J. Robert Hornor (Clarksburg)
 Address Box 225, Clarksburg, West Virginia
 Farm W. Brent Maxwell et al Acres 1300
 Location (waters) West Fork River
 Well No. Five (5) Elev. 1177'
 District Union County Harrison
 The surface of tract is owned in fee by W. B. Maxwell Hrs.
 Address Clarksburg, W. Va.
 Mineral rights are owned by W. B. Maxwell Heirs
 Address Clarksburg, W. Va.
 Drilling commenced November 19, 1912
 Drilling completed January 1, 1913
 Date shot _____ Depth of shot _____
 Open Flow /10ths Water in _____ Inch
 /10ths Merc. in _____ Inch
 Volume _____ Cu. Ft.
 Rock Pressure _____ lbs. _____ hrs.
 Oil _____ bbls., 1st 24 hrs.
 Fresh water _____ feet _____ feet
 Salt water _____ feet _____ feet

Casing and Tubing	Used in Drilling	Left in Well	Packers
Size			
16			Kind of Packer
13			
10	185		Size of
8 1/4	1005		
6 5/8	1484	1484	Depth set
5 3/16			
3	2444	2444	Perf. top
2			Perf. bottom
Liners Used			Perf. top
			Perf. bottom

CASING CEMENTED _____ SIZE _____ No. FT. _____ Date _____
 COAL WAS ENCOUNTERED AT _____ FEET _____ INCHES
 _____ FEET _____ INCHES _____ FEET _____ INCHES
 _____ FEET _____ INCHES _____ FEET _____ INCHES

Formation	Color	Hard or Soft	Top	Bottom	Oil Gas or Water	Depth Found	Remarks
Little Dunkard			540	566			
Big Dunkard			640	672			
Gas Sand			703	783			
Salt Sand			870	920			
S. Sand			950	1000			
Maxon Sand			1102	1140			
Little Lime			1347	1377			
Pencil Cave			1445	1459			
Big Lime			1454	1507			
Big Injun			1507	1633	Gas 1567		
Berea Grit			1992	2007			
Fifty Foot			2023	2050	Gas 2030		
Gordon Stray			2114	2131			
Gordon Sand			2136	2159			
Fourth Sand			2184	2306	Gas 2297		
Fifth Sand			2402	2423	Gas 2406	2418	
Total Depth -				2443			

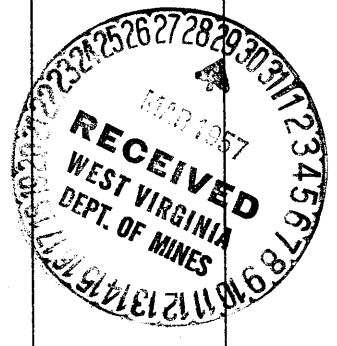

Formation	Color	Hard or Soft	Top	Bottom	Oil, Gas of Water	Depth Found	Remarks

Date..... **March 26**, 19 **57**

APPROVED..... **J. Robert Hornor**, Owner

By.....
(Title)