


June 30 1930

Longitude 80° 15'

H 620  
H 300

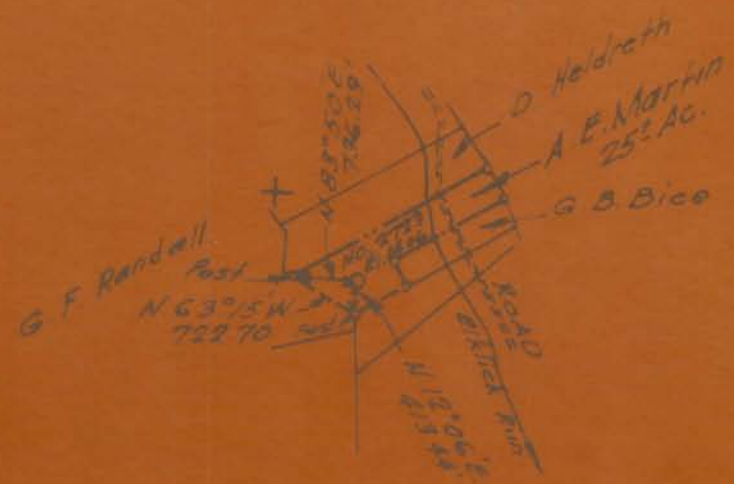

New Location   
 Drill Deeper   
 Abandonment

033-31401

W. LITTLE & JOHNSON, INC.

Company A. M. Snider  
 Address 60 Sunset Dr. Fairmont W. Va.  
 Part A. E. Martin

STATE OF WEST VIRGINIA  
 DEPARTMENT OF MINES  
 OIL AND GAS DIVISION  
 CHARLESTON



DEPARTMENT OF MINES  
 AND GEOLOGICAL SURVEY

AFFIDAVIT OF PLOTTING AND FILLING WELL

AFFIDAVIT SHOULD BE MADE IN THIS STATE AND THE WELL SHOULD BE PLOTTED AND FILLED IN THIS STATE  
 AND SHOULD BE PLOTTED AND FILLED IN THIS STATE AND SHOULD BE PLOTTED AND FILLED IN THIS STATE

NAME OF WELL OPERATOR  
 ADDRESS  
 CITY AND COUNTY  
 STATE

STATE OF WEST VIRGINIA

AFFIDAVIT

STATE OF WEST VIRGINIA

County of

I, the undersigned, being first duly sworn, depose and say that the well described in the foregoing  
 platting and filling of said well was plotted and filled in this State  
 well operator, and participated in the plotting and filling of said well  
 was completed in the State of West Virginia and I believe the foregoing to be true

NAME OF WELL OPERATOR

ADDRESS

CITY AND COUNTY

STATE

DATE

TIME

YEAR

COUNTY

RECEIVED

WEST VIRGINIA  
 DEPT. OF MINES

and that the work of plotting and filling said well was completed in this State

County of \_\_\_\_\_

221

I, Glenn Bailey, being first duly sworn according to law depose and say that I am experienced in the work of plugging and filling oil and gas wells and was employed by Wilhelm & Jackson, Inc., well operator, and participated in the work of plugging and filling ~~the~~ well covered by permit No. \_\_\_\_\_, that said work was commenced on the \_\_\_\_\_ day of \_\_\_\_\_ and that the well was plugged and filled in the manner set forth in the attached affidavit, and that the work of plugging and filling said well was completed on the \_\_\_\_\_ day of \_\_\_\_\_ and further deposes and says not.

Glenn Bailey

Sworn and subscribed before me this 28 day of Feb 1959

John Kelley Jr.  
Notary Public

My commission expires:

Oct 5 1961