



2.63^s
18^w

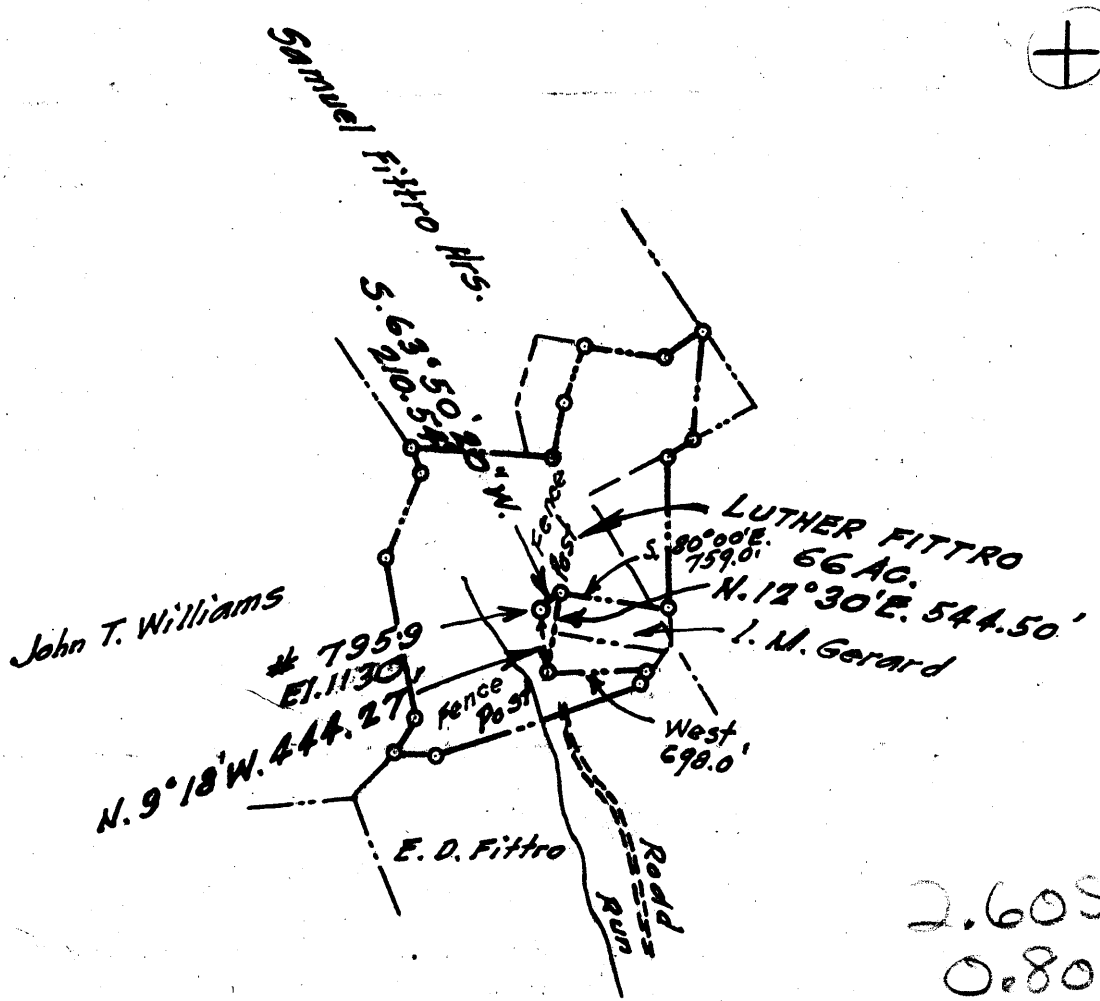

2.60S
0.80W

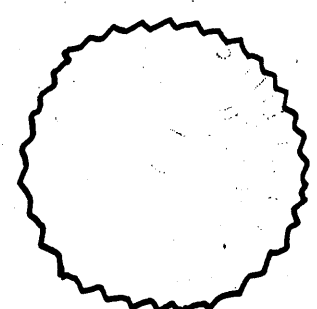

New Location
 Drill Deeper
 Abandonment

Company A. M. Snider
 Address 60 Sunset Dr, Fairmont, W. Va.
 Farm Luther Fittro
 Tract _____ Acres 66 Lease No. _____
 Well (Farm) No. 7959 Serial No. _____
 Elevation (Spirit Level) 1130
 Quadrangle Clarksburg
 County Harrison District Coal
 Engineer Dennis H. Higman
 Engineer's Registration No. 1868
 File No. 1 Drawing No. 8
 Date Jan. 27, 1959 scale 1" = 80 P.

STATE OF WEST VIRGINIA
 DEPARTMENT OF MINES
 OIL AND GAS DIVISION
 CHARLESTON

WELL LOCATION MAP
 FILE NO. HAB-1488-A

+ Denotes location of Well on United States Topographic Maps, scale 1 to 62,500, latitude and longitude lines being represented by border lines as shown
 - Denotes one inch spaces on border line of original tracing.



1564

STATE OF WEST VIRGINIA
DEPARTMENT OF MINES
OIL AND GAS DIVISION

Quadrangle Clarksburg
Permit No. 1688-A

WELL RECORD

Oil or Gas Well Gas
(Kind)

Company Wilhelm & Jackson, Inc.
Address 508 Buckhannon Ave, Clarksburg, W. Va.
Farm L. Pittro Acres 66
Location (waters) _____
Well No. HNG # 7959 Elev. 1190
District Coal County Harrison
The surface of tract is owned in fee by L. Pittro
Address Wilsonburg, W. Va.
Mineral rights are owned by _____
Address _____
Drilling commenced July 1, 1908
Drilling completed Sept. 25, 1908
Date Shot _____ From _____ To _____
With _____
Open Flow _____ /10ths Water in _____ Inch
_____ /10ths Merc. in _____ Inch
Volume _____ Cu. Ft.
Rock Pressure _____ lbs. _____ hrs.
Oil _____ bbls., 1st 24 hrs.
WELL ACIDIZED _____
WELL FRACTURED _____

Casing and Tubing	Used in Drilling	Left in Well	Packers
Size			Kind of Packer
16			
13			<u>Anchor</u>
10	<u>263</u>		Size of <u>2" x 5"</u>
8 3/4	<u>1352</u>		
6 5/8	<u>1520</u>	<u>1520</u>	Depth set <u>2918'</u>
5 3/16	<u>2176</u>	<u>2170</u>	
3			Perf. top _____
2	<u>3098</u>	<u>3098</u>	Perf. bottom _____
Liners Used			Perf. top _____
			Perf. bottom _____

CASING CEMENTED _____ SIZE _____ No. Ft. _____ Date _____

COAL WAS ENCOUNTERED AT None FEET _____ INCHES
_____ FEET _____ INCHES FEET _____ INCHES
_____ FEET _____ INCHES FEET _____ INCHES

RESULT AFTER TREATMENT _____
ROCK PRESSURE AFTER TREATMENT _____
Fresh Water _____ Feet _____ Salt Water _____ Feet _____

Formation	Color	Hard or Soft	Top	Bottom	Oil, Gas or Water	Depth	Remarks
(Top 65' below Pittsburg Coal)							
Dunkard Sand			460	600			
Salt Sand			810	973			
Little Lime			1301	1311			
Big Lime			1328	1396			
Injun Sand			1396	1476			
Berea Sand			1816	1834			
Fifty Foot Sand			1896	1985			
Thirty Foot Sand			2045	2063			
Gordon Sand			2210	2224			
Fourth Sand			2240	2253			
Fifth Sand			2325	2336			
Speechley Sand			3052	3059			
Total Depth				3091			

(over)

