



Latitude 39° 20'

Longitude 80° 25'

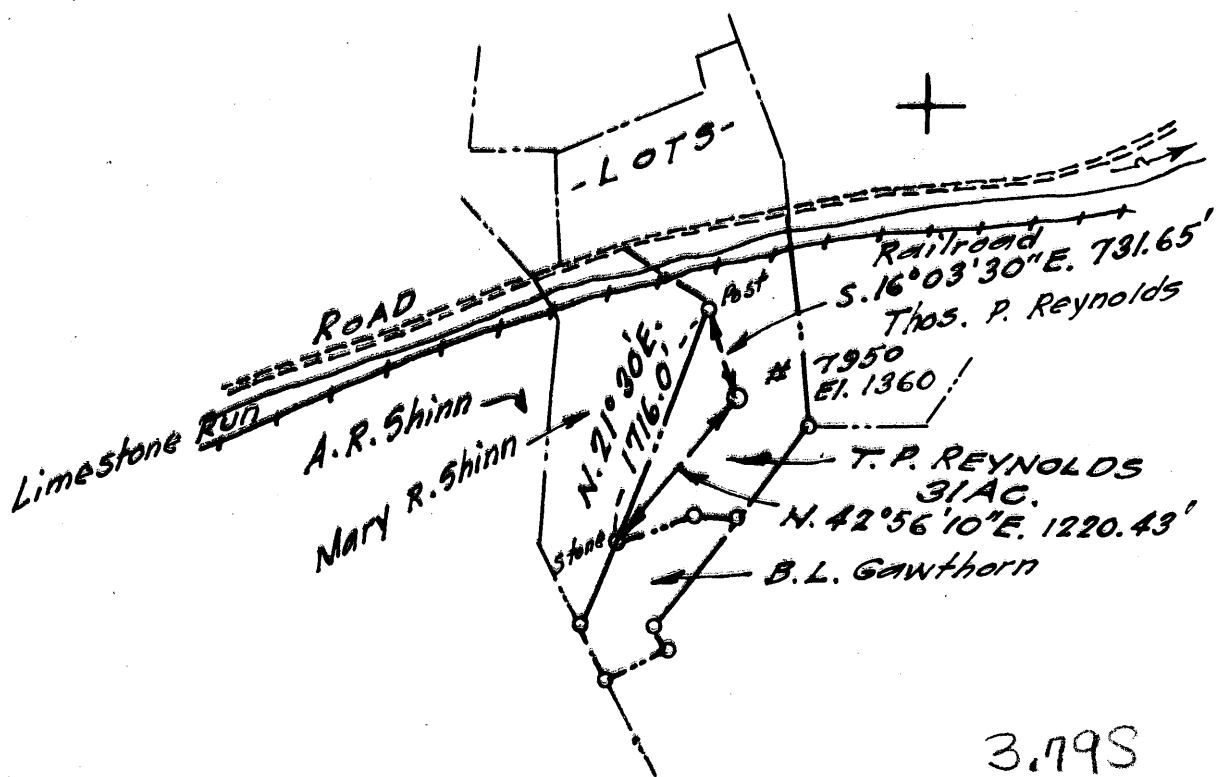

3.79S
2.15W

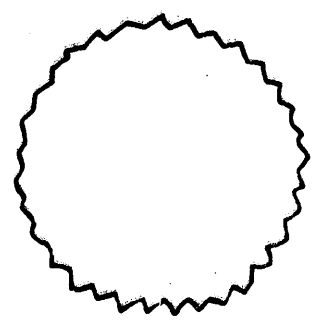

New Location
 Drill Deeper
 Abandonment

Company A. M. Spider
 Address 60 Sunset Dr, Fairmont, W. Va.
 Farm T. P. Reynolds
 Tract _____ Acres 31 Lease No. _____
 Well (Farm) No. 7950 Serial No. _____
 Elevation (Spirit Level) 1360
 Quadrangle Clarksburg
 County Harrison District Clark
 Engineer Maris H. Helgman
 Engineer's Registration No. 1868
 File No. 1 Drawing No. 2
 Date Jan. 27, 1959 Scale 1" = 800'

STATE OF WEST VIRGINIA
 DEPARTMENT OF MINES
 OIL AND GAS DIVISION
 CHARLESTON

WELL LOCATION MAP
 FILE NO. HAR-1694-A

+ Denotes location of well on United States Topographic Maps, scale 1 to 62,500, latitude and longitude lines being represented by border lines as shown.
 - Denotes one inch spaces on border line of original tracing.



1057

STATE OF WEST VIRGINIA
DEPARTMENT OF MINES
OIL AND GAS DIVISION

Quadrangle Clarksburg

Permit No. 1644 X

WELL RECORD

Oil or Gas Well GAS

(KIND)

Company Wilhelm & Jackson, Inc.
Address 508 Buokhannon Ave., Clarksburg, W. Va.
Farm T. P. Reynolds Acres 31

Location (waters)
Well No. HNG 7950 Elev. 1360

District Clark County Harrison

The surface of tract is owned in fee by T.P. Reynolds
Address Clarksburg, W. Va.

Mineral rights are owned by T. P. Reynolds
Address _____

Drilling commenced Sept. 7, 1903

Drilling completed Nov. 21, 1903

Date Shot _____ From _____ To _____

With _____

Open Flow _____ /10ths Water in _____ Inch

_____ /10ths Merc. in _____ Inch

Volume _____ Cu. Ft.

Rock Pressure _____ lbs. _____ hrs.

Oil _____ bbls., 1st 24 hrs.

WELL ACIDIZED _____

WELL FRACTURED _____

RESULT AFTER TREATMENT _____

ROCK PRESSURE AFTER TREATMENT _____

Fresh Water _____ Feet _____ Salt Water _____ Feet

Casing and Tubing	Used in Drilling	Left in Well	Packers
Size			Kind of Packer _____
16			
13			
10	140		Size of <u>5 x 2 set</u>
8 1/4	1030	1030	<u>2295</u>
6 5/8	1089	1089	_____
5 3/16	2272	2272	
3	2386	2386	Perf. top _____
2			Perf. bottom _____
Liners Used			Perf. top _____
			Perf. bottom _____


CASING CEMENTED _____ SIZE _____ No. Ft. _____ Date _____

COAL WAS ENCOUNTERED AT _____ FEET _____ INCHES

_____ FEET _____ INCHES _____ FEET _____ INCHES

_____ FEET _____ INCHES _____ FEET _____ INCHES

Formation	Color	Hard or Soft	Top	Bottom	Oil, Gas or Water	Depth	Remarks
Pitts. Coal			15	22			
Dunkard Sand			510	600			
Gas Sand			712	820			
Salt Sand			845	1020			
Maxon Sand			1070	1108			
Injun Sand			1445	1545			
Big Lime			1365	1445			
30 Ft. Sand			1832	1854			
50 Ft. Sand			1925	1978			
Stray Sand			2200	2215			
Gordon Sand			2215	2240			
Fifth Sand			2365	2390			
Speechley Sand			3072	3082			

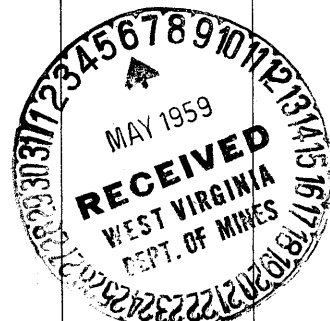

JUL 23 1959

(over)