

- New Location ..
- Drill Deeper ..
- Abandonment ..

Formerly Hope Natural Gas Co. Well No 8080

5.625  
2.13W

Company	LURAY LAND INC.
Address	POINT PLEASANT, WEST VA.
Farm	C. L. ANDREWS
Tract	Acres 1000 Lease No.
Well (Farm) No.	1 Serial No.
Elevation (Spirit Level)	1136'
Quadrangle	CLARKSBURG
County	HARRISON District UNION
Engineer	H. P. SUTER
Engineer's Registration No.	1805
File No.	Drawing No.
Date	5 JUNE, 1959 Scale 1"=1320'

STATE OF WEST VIRGINIA  
DEPARTMENT OF MINES  
OIL AND GAS DIVISION  
CHARLESTON

**WELL LOCATION MAP**  
FILE NO. HAR-1721-A

+ Denotes location of well on United States Topographic Maps, scale 1 to 62,500, latitude and longitude lines being represented by border lines as shown.

- Denotes one inch spaces on border line of original tracing.



1604

STATE OF WEST VIRGINIA  
DEPARTMENT OF MINES  
OIL AND GAS DIVISION

Quadrangle Clarksburg  
Permit No. 171A

WELL RECORD

Oil or Gas Well \_\_\_\_\_ (KIND)

Company Hope Natural Gas Company  
Address Clarksburg, West Virginia  
Farm C. L. Andrews Acres 1000  
Location (waters) \_\_\_\_\_  
Well No. 8080 (1 Hope) Elev. 1136  
District Union County Harrison  
The surface of tract is owned in fee by \_\_\_\_\_  
Address \_\_\_\_\_  
Mineral rights are owned by \_\_\_\_\_  
Address \_\_\_\_\_  
Drilling commenced April 25, 1919  
Drilling completed Aug. 23, 1919  
Date Shot 8-27-19 From Fifth To \_\_\_\_\_  
With 5-19-49 Maxon  
Open Flow \_\_\_\_\_ /10ths Water in \_\_\_\_\_ Inch  
\_\_\_\_\_ /10ths Merc. in \_\_\_\_\_ Inch  
Volume \_\_\_\_\_ Cu. Ft.  
Rock Pressure \_\_\_\_\_ lbs. \_\_\_\_\_ hrs.  
Oil \_\_\_\_\_ bbls., 1st 24 hrs.  
WELL ACIDIZED \_\_\_\_\_  
WELL FRACTURED \_\_\_\_\_


Casing and Tubing	Used in Drilling	Left in Well	Packers
Size			Kind of Packer _____
16			
13			
10	165'	165'	Size of _____
8 3/4	636' 10"	636' 10"	
6 5/8	1482'	24'	Depth set _____
<del>xxxxx</del> 7"	1146'	1146'	
3			Perf. top _____
2	2380'	Pulled	Perf. bottom _____
Liners Used			Perf. top _____
			Perf. bottom _____

CASING CEMENTED \_\_\_\_\_ SIZE \_\_\_\_\_ No. Ft. \_\_\_\_\_ Date \_\_\_\_\_

COAL WAS ENCOUNTERED AT \_\_\_\_\_ FEET \_\_\_\_\_ INCHES  
\_\_\_\_\_ FEET \_\_\_\_\_ INCHES \_\_\_\_\_ FEET \_\_\_\_\_ INCHES  
\_\_\_\_\_ FEET \_\_\_\_\_ INCHES \_\_\_\_\_ FEET \_\_\_\_\_ INCHES

RESULT AFTER TREATMENT \_\_\_\_\_  
ROCK PRESSURE AFTER TREATMENT \_\_\_\_\_  
Fresh Water \_\_\_\_\_ Feet \_\_\_\_\_ Salt Water \_\_\_\_\_ Feet \_\_\_\_\_

Formation	Color	Hard or Soft	Top	Bottom	Oil, Gas or Water	Depth	Remarks
Pittsburgh Coal			36	42			
Dunkard Sand			425	465			
Salt Sand			720	1012			
Maxon Sand			1121	1184	Gas at 1174 to 1184		
Ingun Sand			1482	1573			
Fifty Foot Sand			1940	1960	Gas at 1940		
Thirty Foot Sand			1976	2203			
Stray Sand			2214	2217			
Fifth Sand			2344	2351	Gas at 2345 to 2350		
Total Depth				2380			
Filled	1238	6-14-49					

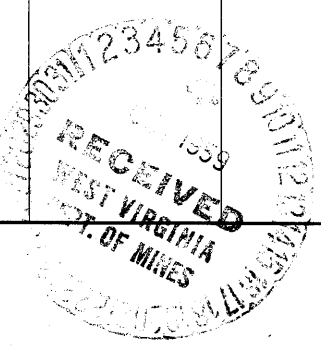

MAR 26 1960

Formation	Color	Hard or Soft	Top	Bottom	Oil, Gas or Water	Depth Found	Remarks

Date **May 29,** \_\_\_\_\_, 19 **59**  
 APPROVED **LuRay Land, Inc.**, Owner  
 By *Byron M. Finch*  
**Byron M. Finch** (Title) **Consultant**