


Latitude 39° 20'

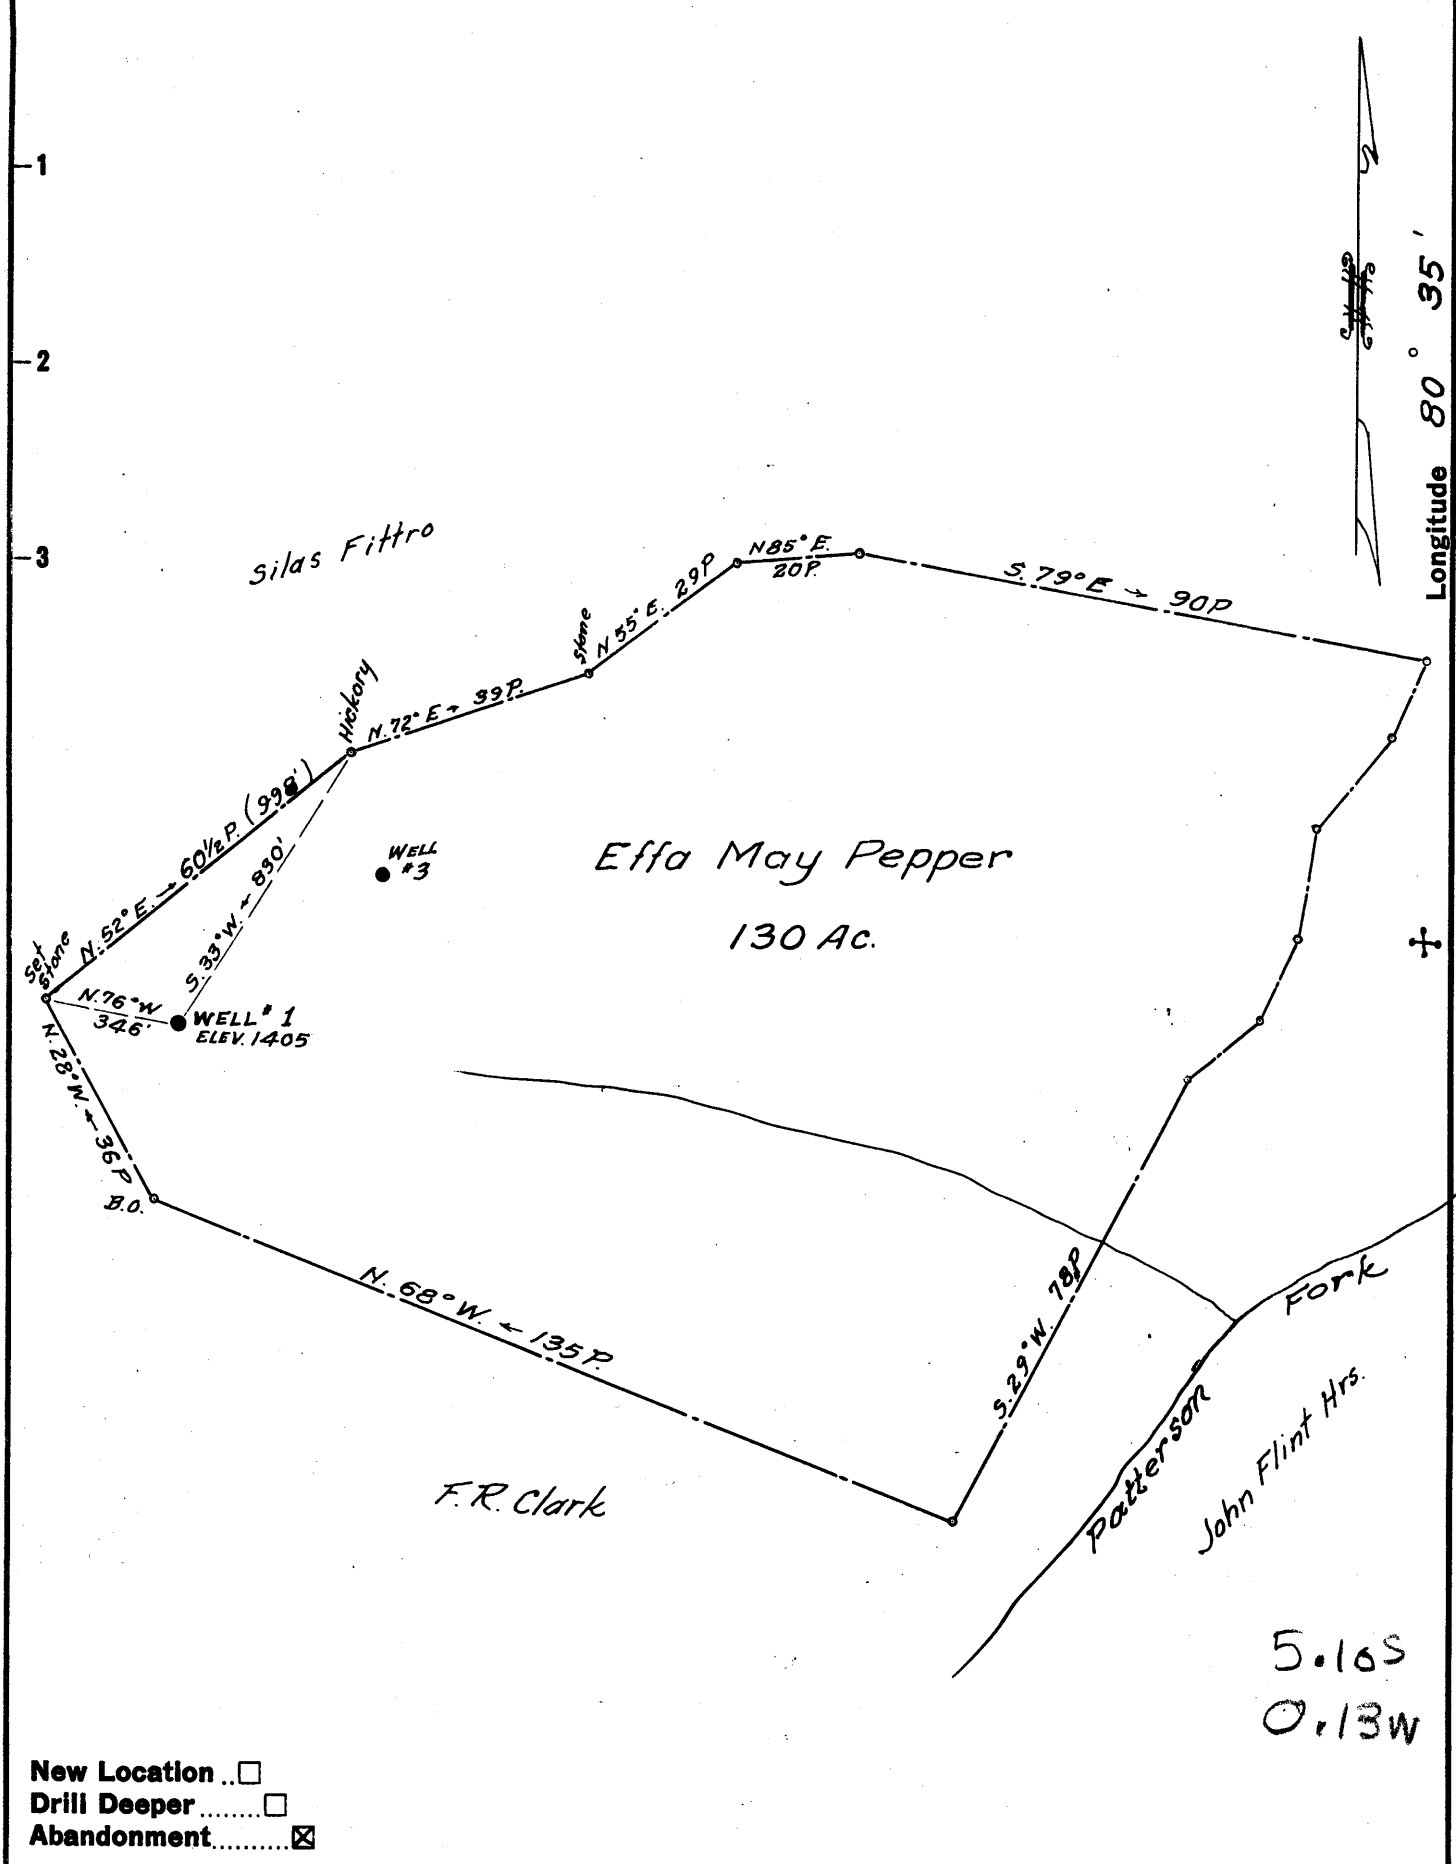

New Location...
 Drill Deeper.....
 Abandonment.....

5.10S
 0.13W

Company Fluharty & Williamson - Dual Fluharty, Agt.
 Address Big Springs, W.Va.
 Farm Effa May Pepper
 Tract 1 Acres 130 Lease No. _____
 Well (Farm) No. 1 Serial No. _____
 Elevation (Spirit Level) 1405
 Quadrangle Centerpoint
 County Harrison District Ten Mile
 Engineer Parker E. Peters
 Engineer's Registration No. 485
W. Ireland - Field
 File No. _____ Drawing No. _____
 Date Sept. 25, 1959 Scale 1" = 30 P.

STATE OF WEST VIRGINIA
 DEPARTMENT OF MINES
 OIL AND GAS DIVISION
 CHARLESTON

WELL LOCATION MAP
 FILE NO. HAR-1727-A

+ Denotes location of well on United States Topographic Maps, scale 1 to 62,500, latitude and longitude lines being represented by border lines as shown.

- Denotes one inch spaces on border line of original tracing.



1617

STATE OF WEST VIRGINIA
DEPARTMENT OF MINES
OIL AND GAS DIVISION

Quadrangle Centerfront
Permit No. WFA

WELL RECORD

Oil or Gas Well (KIND)

Company Fluharty & Willigason
Address Big Springs, W. Va.
Farm Effa May Pepper Acres 150
Location (waters) Patterson Fork
Well No. 1 Elev. 1405
District Ten Mile County Harrison
The surface of tract is owned in fee by Effa May Pepper
Address Salem, W. Va.
Mineral rights are owned by _____
Address _____
Drilling commenced July 29, 1903
Drilling completed Sept 5, 1903
Date Shot Sept 14, 1903 from _____ To _____
With 40 Qts 100 Qts
Open Flow _____ /10ths Water in Unknown Inch
_____ /10ths Merc. in _____ Inch
Volume No record Cu. Ft.
Rock Pressure no record lbs. _____ hrs.
Oil No record bbls., 1st 24 hrs.
WELL ACIDIZED _____
WELL FRACTURED _____

Casing and Tubing	Used in Drilling	Left in Well	Packers
Size			Kind of Packer
16			
13			
10			Size of
8 1/4			
6 3/8 2644			Depth set
5 3/16			
3			Perf. top
2			Perf. bottom
Liners Used			Perf. top
			Perf. bottom

CASING CEMENTED _____ SIZE _____ No. Ft. _____ Date _____

COAL WAS ENCOUNTERED AT _____ FEET _____ INCHES
_____ FEET _____ INCHES _____ FEET _____ INCHES
_____ FEET _____ INCHES _____ FEET _____ INCHES

RESULT AFTER TREATMENT _____
ROCK PRESSURE AFTER TREATMENT _____
Fresh Water _____ Feet Salt Water _____ Feet

Formation	Color	Hard or Soft	Top	Bottom	Oil, Gas or Water	Depth	Remarks
Pittsburgh Coal			1125				
Top Garden Sand			3219	3236			
Total Depth				3236			
This is all of record that is Available							

JUN 29 1900

