

New Location ..
 Drill Deeper
 Abandonment..... 4723

FORMERLY H. N. G. Co. WELL N^o 4723

2,435
4.40W

Company A. M. SNIDER

Address HUNDRED, W. VA.

Farm C. H. GREEN

Tract _____ Acres 143.1 Lease No. 17121

Well (Farm) No. _____ Serial No. 4723

Elevation (Spirit Level) 1335'

Quadrangle CLARKSBURG SE

County HARRISON District COAL

Engineer HENRY A. HAIN

Engineer's Registration No. 3150

File No. A.M.S 35-60 Drawing No. _____

Date May 10, 1960 Scale 1" = 500'

STATE OF WEST VIRGINIA
 DEPARTMENT OF MINES
 OIL AND GAS DIVISION
 CHARLESTON

WELL LOCATION MAP
 FILE NO. HAR-1757-A

+ Denotes location of well on United States Topographic Maps, scale 1 to 62,500, latitude and longitude lines being represented by border lines as shown.

- Denotes one inch spaces on border line of original tracing.



1636

STATE OF WEST VIRGINIA
DEPARTMENT OF MINES
OIL AND GAS DIVISION

Quadrangle Clarksburg JE

Permit No. 1757A

WELL RECORD

Oil or Gas Well Gas
(KIND)

Company I.L. Roberts & Sons
Address Box 146, Mannington, W. Va.
Farm C. H. Green Acres 143.1
Location (waters) West Fork River
Well No. 4723 Elev. 1335'
District Coal County Harrison
The surface of tract is owned in fee by John Warner
Old Bridgeport Road Address Bridgeport, W. Va.
Mineral rights are owned by Consolidation Coal Co.
Address Monongah, W. Va.

| Casing and Tubing | Used in Drilling | Left in Well | Packers |
|-------------------|------------------|-----------------|---------------------------|
| Size | | | |
| 16 | | | Kind of Packer |
| 13 | | | <u>10x15 C.I.F.</u> |
| 10 | <u>345'</u> | <u>Cemented</u> | Size of <u>6-5/8 Shoe</u> |
| 8 1/4 | | | <u>6x2 B.S.A. Set at</u> |
| 6 5/8 | <u>1675'</u> | <u>1675'</u> | Depth set <u>2439'6"</u> |
| 5 3/16 | | | |
| 3 | | | Perf. top |
| <u>2" Perf.</u> | <u>2789'6"</u> | <u>2789'6"</u> | Perf. bottom |
| Liners Used | <u>5'</u> | <u>5'</u> | Perf. top |
| | | | Perf. bottom |


Drilling commenced March 10, 1917
Drilling completed Aug. 28, 1917
Date Shot 12/19/24 From _____ To _____
With 30 qts. in fifth sand
Open Flow /10ths Water in _____ Inch
/10ths Merc. in _____ Inch
Volume _____ Cu. Ft.
Rock Pressure _____ lbs. _____ hrs.
Oil _____ bbls., 1st 24 hrs.
WELL ACIDIZED _____
WELL FRACTURED _____

CASING CEMENTED 10" SIZE 245-345 Ft. 8/11/17 Date

COAL WAS ENCOUNTERED AT 289 FEET _____ INCHES
_____ FEET _____ INCHES FEET _____ INCHES
_____ FEET _____ INCHES FEET _____ INCHES

RESULT AFTER TREATMENT _____
ROCK PRESSURE AFTER TREATMENT _____
Fresh Water _____ Feet Salt Water _____ Feet

| Formation | Color | Hard or Soft | Top | Bottom | Oil, Gas or Water | Depth | Remarks |
|-----------------|-------|--------------|------|--------|-------------------|--------|---------|
| Pittsburgh Coal | | | 289 | 299 | | | |
| Dunkard sand | | | 500 | 695 | | | |
| Salt sand | | | 815 | 1275 | Water | 1080 | |
| Maxon sand | | | 1525 | 1565 | | | |
| Injun sand | | | 1675 | 1835 | Gas | 1764-8 | |
| Gantz sand | | | 1985 | | | | |
| 30 ft, sand | | | 2265 | 2350 | Gas | 2272 | |
| Gorddn sand | | | 2395 | 2430 | | | |
| Fifth sand | | | 2707 | 2749 | Gas | 2721 | |
| Total Depth | | | | 2010 | | | |
| Deeper | | | | 3621 | | | |
| Filled to | | | | 2770 | | | |

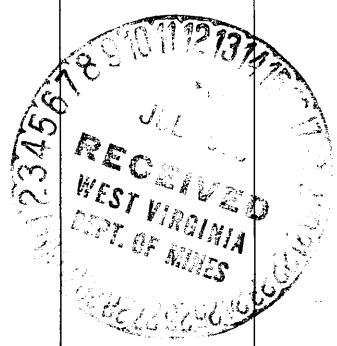

MAN 3 1961