


Latitude 39° 20'

Longitude 80° 20'

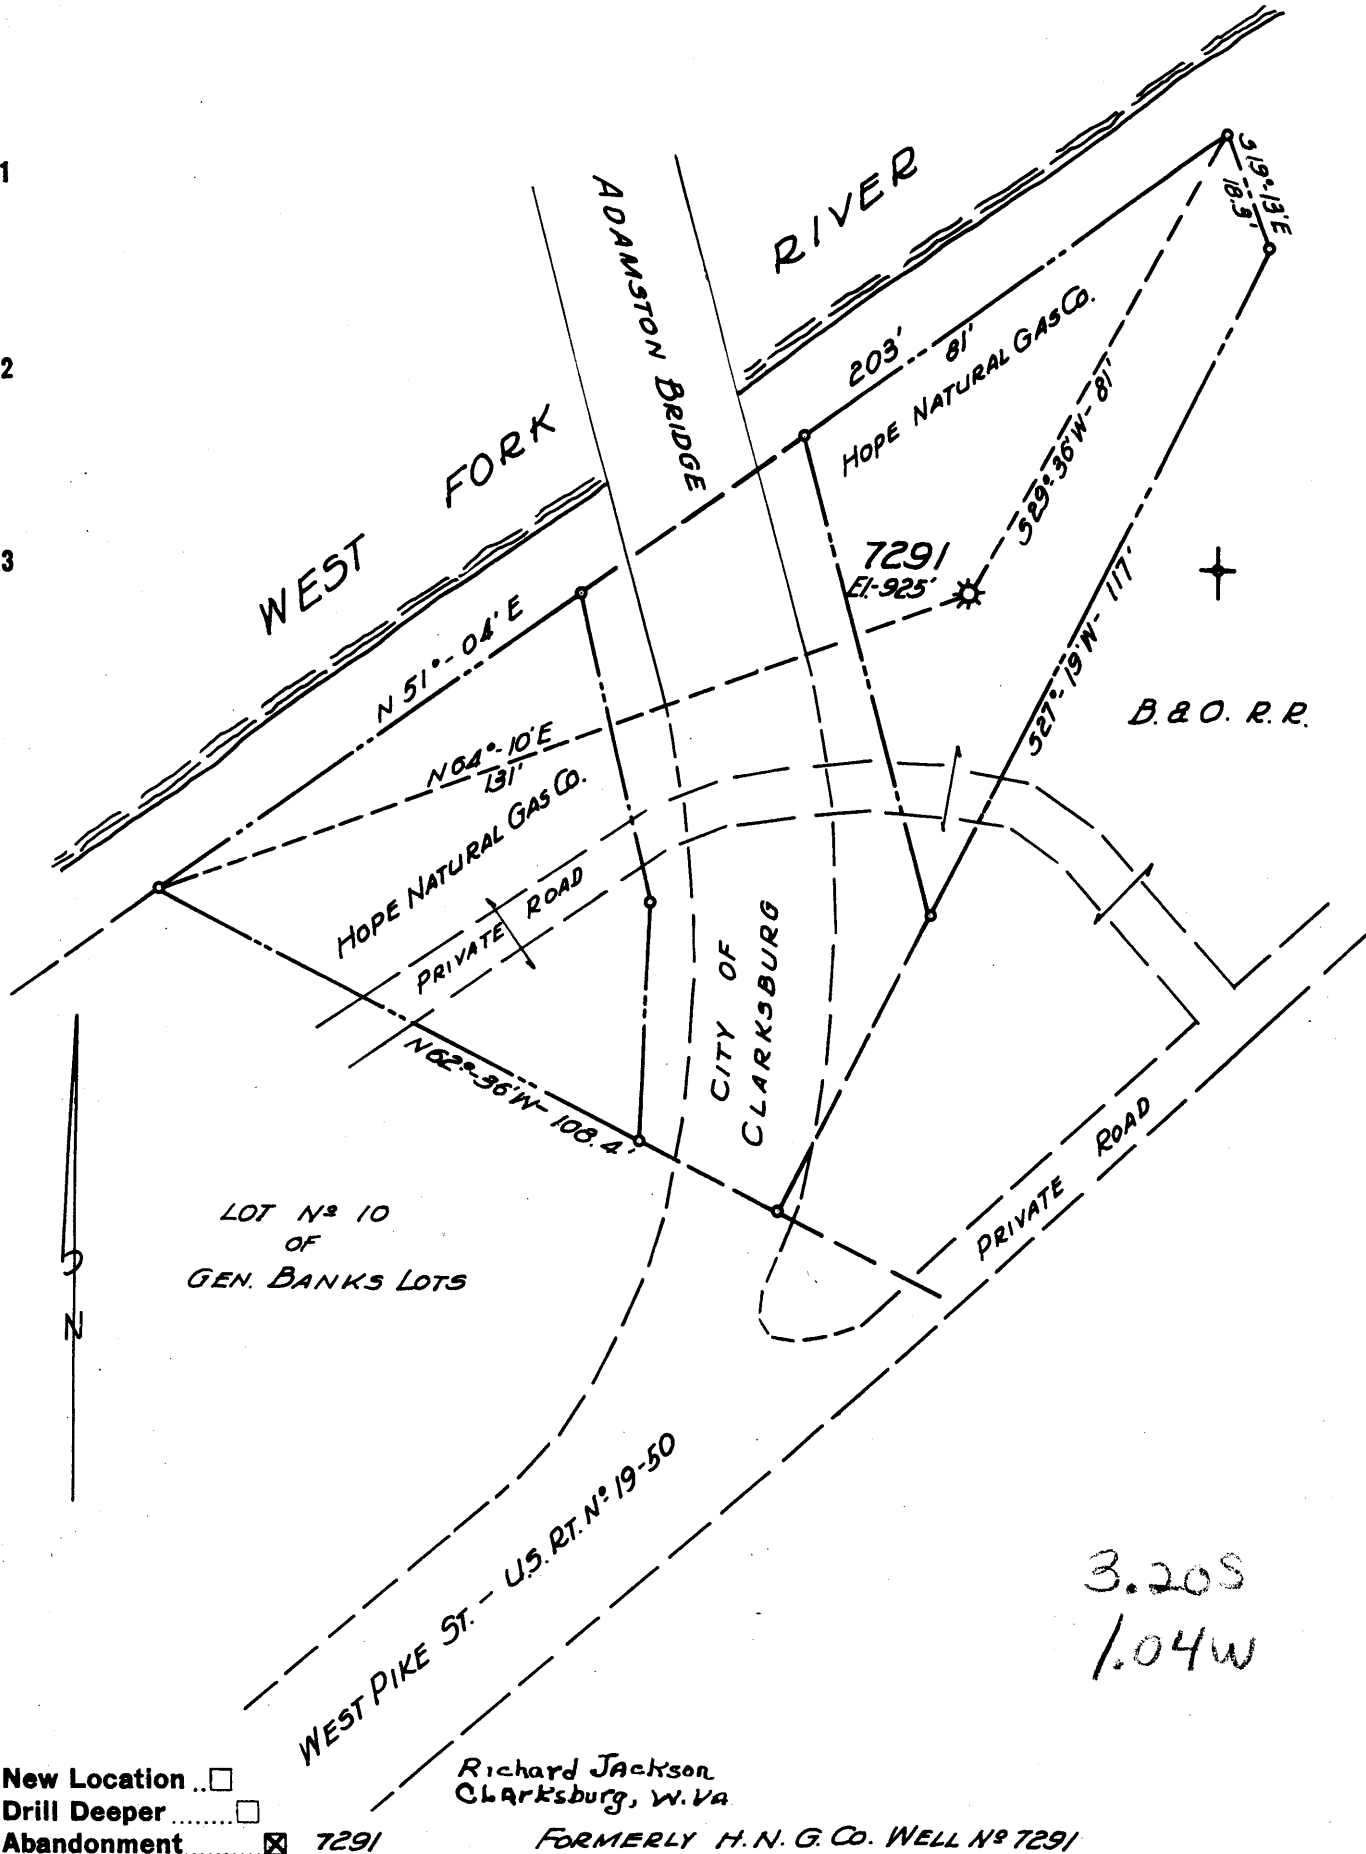

LOT N° 10 OF GEN. BANKS LOTS

Richard Jackson
Clarksburg, W. Va

FORMERLY H. N. G. CO. WELL N° 7291

New Location
 Drill Deeper
 Abandonment 7291

Company A. M. SNIDER
 Address HUNDRED, W. VA.
 Farm HOPE NATURAL GAS CO. (TOLL GATE)
 Tract _____ Acres 0.242 Lease No. 44641
 Well (Farm) No. _____ Serial No. 7291
 Elevation (Spirit Level) 925'
 Quadrangle CLARKSBURG
 County HARRISON District COAL
 Engineer HENRY A. HAIN
 Engineer's Registration No. 3150
 File No. AMS - 38-60 Drawing No. _____
 Date MAY 11, 1960 Scale 1" = 30'

STATE OF WEST VIRGINIA
 DEPARTMENT OF MINES
 OIL AND GAS DIVISION
 CHARLESTON

WELL LOCATION MAP
 FILE NO. HAR-1759-A

+ Denotes location of well on United States Topographic Maps, scale 1 to 62,500, latitude and longitude lines being represented by border lines as shown.

- Denotes one inch spaces on border line of original tracing.

HOPE NATURAL GAS (POHL CASE) NO. 7291 WEST.

Coal District, Harrison County.

By Richard Jackson, Inc. 614 E. Main St., Clarksburg, W. Va.

Drilled under permit No. Mar-1759-A; Clarksburg quadrangle.

On 0.242 acres on West Fork River.

Elevation 925' L.

No record of drilling commenced; completed March 10, 1911.

Well shot 10-4-1911 Fifth Sand.

Casing: 10" 85' left in; 8 1/2" 245' (pulled) 6-5/8" 1400' left in. 8 x 10 BH packer,
3" shoe set at 1400'.

Gas 1160'; 1310'; 2233-2249'.

Gas Well.

Record from Mrs. Griffith to RCI, Aug. 2, 1931.

O. F. No. 1351

	Top.	Bottom.
Little Dunkard Sand	260	300
Big Dunkard Sand	440	480
Salt Sand	670	845
Maxon Sand	1125	1135
Big Line	1135	1300
Injun Sand	1330	1440
Fifty Ft. Sand	1806	1910
Thirty Ft. Sand	1940	1970
Stray Sand	2020	2098
Gordon Sand	2112	2135
Fourth Sand	2160	2180
Fifth Sand	2230	2233
Total Depth		1195
Deeper		2298
Now 1355		1355