


0
-1
-2
-3

Longitude 80° 30'

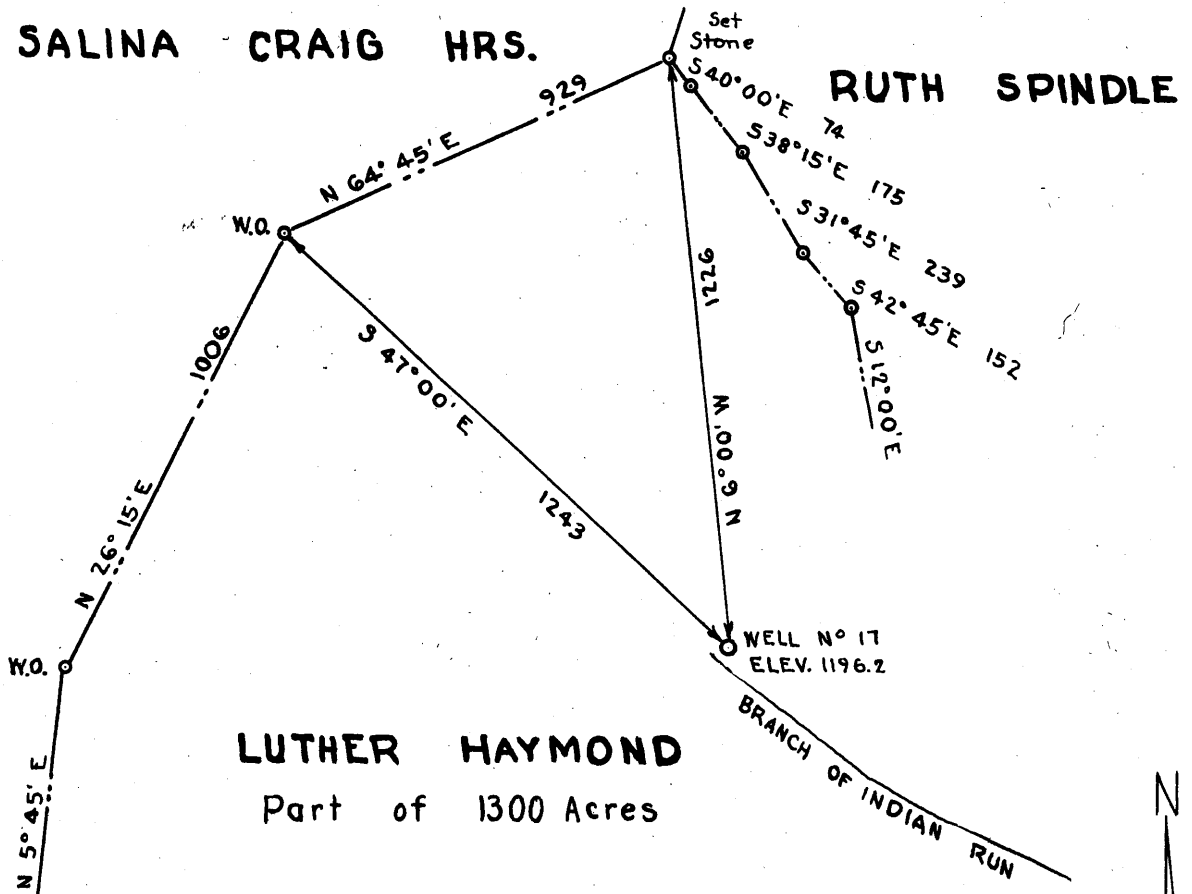

0.5S
3.25W

- New Location
- Drill Deeper
- Redrill
- Abandonment

Company	BLAUSER OIL & GAS WELL SUPPLY CO		
Address	133 HILLCREST DR., MARIETTA, OHIO		
Farm	LUTHER HAYMOND		
Tract	Acres	Lease No.	
Well (Farm) No.	17	Serial No.	
Elevation (Spirit Level)	1196.2		
Quadrangle	CENTERPOINT		
County	HARRISON	District TENMILE	
Engineer	<i>John C. Thacker</i>		
Engineer's Registration No.	3229		
File No.	Drawing No.		
Date	NOV. 21, 1960 Scale 1"=400'		

STATE OF WEST VIRGINIA
DEPARTMENT OF MINES
OIL AND GAS DIVISION
CHARLESTON

WELL LOCATION MAP
FILE NO. **HAR-1770-A**

+ Denotes location of well on United States Topographic Maps, scale 1 to 62,500, latitude and longitude lines being represented by border lines as shown.

— Denotes one inch spaces on border line of original tracing.

LUMBER HAYWARD NO. 17 WELL

Tennile District, Harrison County, W. Va.

By Blausser Gas & Oil Well Supply 135 Hillcrest Drive Marietta, Ohio.

Drilled under permit No. Mar-1770-R; Centerpoint quadrangle.

On 1300 acres N (E) side of NW of Indian Creek.

Elevation 1196.2' L.

Casing: 10" 248', 8" 1424', 6-5/8" 2399'.

Record from Mrs. Griffith to RCT, Aug. 2, 1961.

O. F. No. 1649

	Top.	Bottom.
Pittsburgh Coal	1004	
Salt Sand	1870	1935
Big Injun	2295	2380
Stray Sand	3017	3050
Gordon Sand	3057	3085
Cil	3035	3065
Total Depth		3079