


Latitude 39° 15'

Longitude 80° 30'

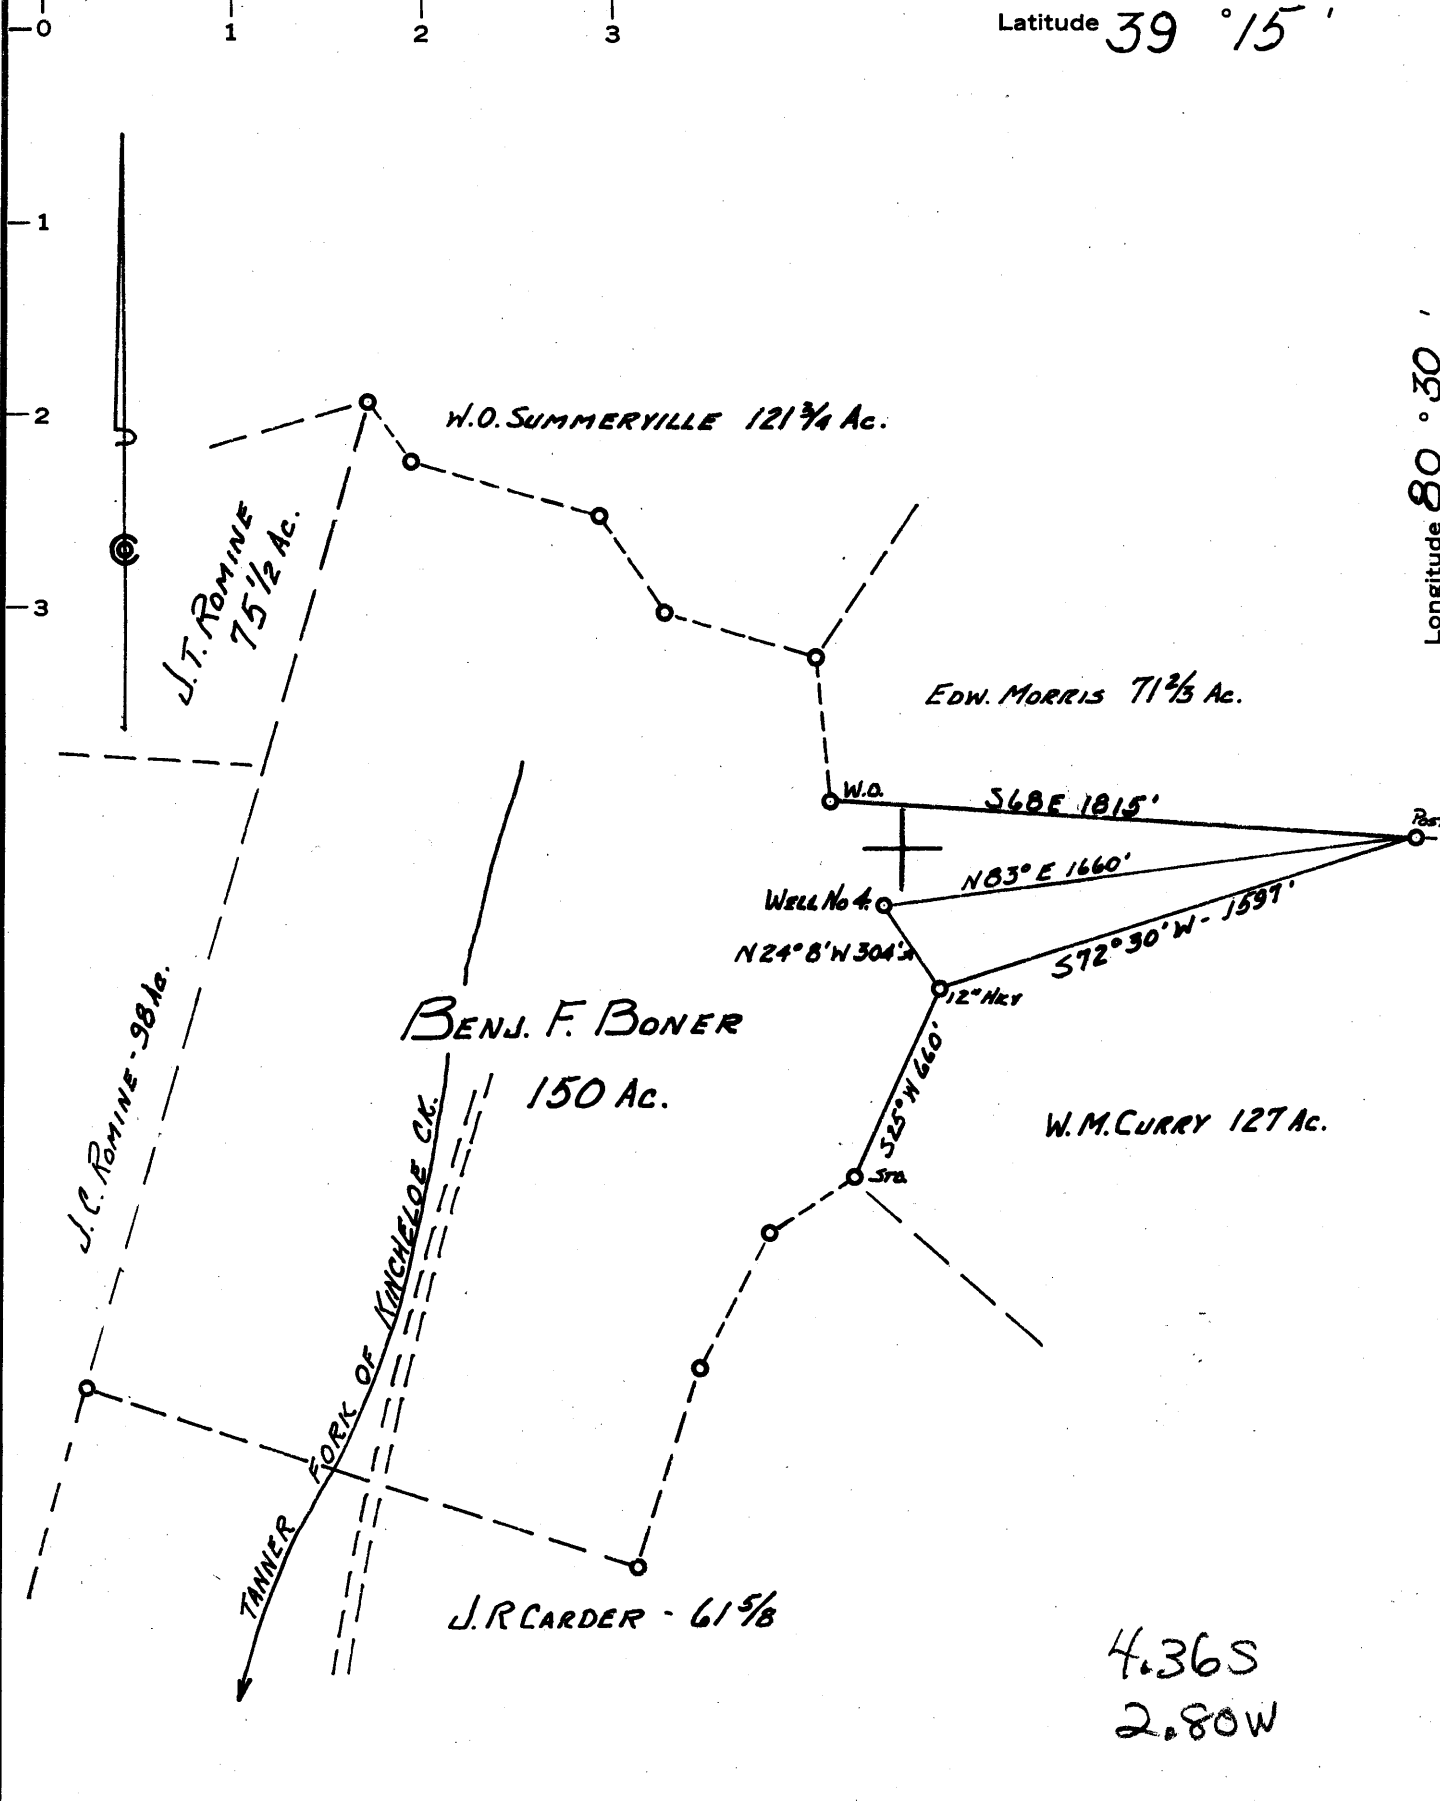

4.36S
2.80W

- New Location
- Drill Deeper
- Abandonment

FORMER SOUTH PENN OIL CO. LEASE #23759

Company PACK & JACKSON
 Address Box 175, HAMLIN, W.VA.
 Farm BENJ. F. BONER.
 Tract _____ Acres 150. Lease No. _____
 Well (Farm) No. 4 Serial No. _____
 Elevation (Spirit Level) 1406'
 Quadrangle VADIS
 County HARRISON District UNION
 Engineer John W. Hamilton
 Engineer's Registration No. 2274
 File No. _____ Drawing No. _____
 Date MAR 22, 1962 Scale 1" = 600'

STATE OF WEST VIRGINIA
 DEPARTMENT OF MINES
 OIL AND GAS DIVISION
 CHARLESTON

WELL LOCATION MAP
 FILE NO. HAR-1799-A

+ Denotes location of well on United States Topographic Maps, scale 1 to 62,500, latitude and longitude lines being represented by border lines as shown.

— Denotes one inch spaces on border line of original tracing.