


Latitude 39° 50'

Longitude 80° 25'

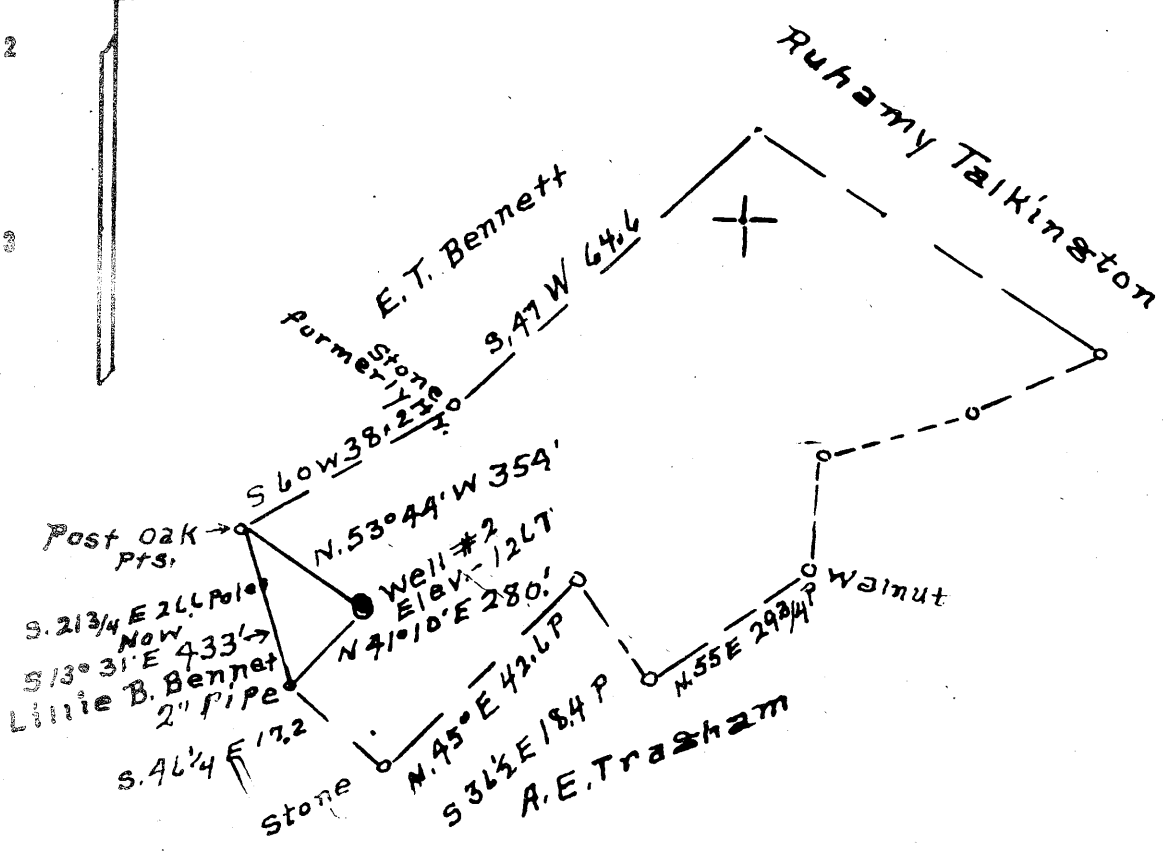

3.05  
3.53W

Surface = A.E. Tringham  
Wallace, W. Va.  
Coal = Mountaineer Coal Co.  
% Ray M. Henderson  
P.O. Box 1632  
Fairmont W. Va.

How Location   
Drill Deeper   
Abandonment

I, The undersigned hereby certify that this map is correct to the best of my knowledge and belief and shows all the information required by Paragraph 6 of the rules and regulations of the Oil and Gas section of the mining laws of West Virginia

Company Cecil Chisler & son  
 Address R# Fairview W. Va.  
 Farm J.F. Copenhaver  
 Tract 1 Acres 3 1/2 Lease No. \_\_\_\_\_  
 Well (Farm) No. 2 Serial No. \_\_\_\_\_  
 Elevation (Spirit Level) 1267'  
 Quadrangle Clarksburg  
 County Harrison District Sardis  
 Engineer A. L. Headley  
 Engineer's Registration No. 2021  
 File No. \_\_\_\_\_ Drawing No. \_\_\_\_\_  
 Date 6-22-63 Scale 1" = 500

STATE OF WEST VIRGINIA  
DEPARTMENT OF MINES  
OIL AND GAS DIVISION  
CHARLESTON

WELL LOCATION MAP  
FILE NO. HAR-1806-A

+ Denotes location of well on United States Topographic Maps, scale 1 to 62,500, latitude and longitude lines being represented by border lines as shown.  
 - Denotes one inch spaces on border line of original tracing.