


20,400

LATITUDE 39° 15'

LONGITUDE 80 25'

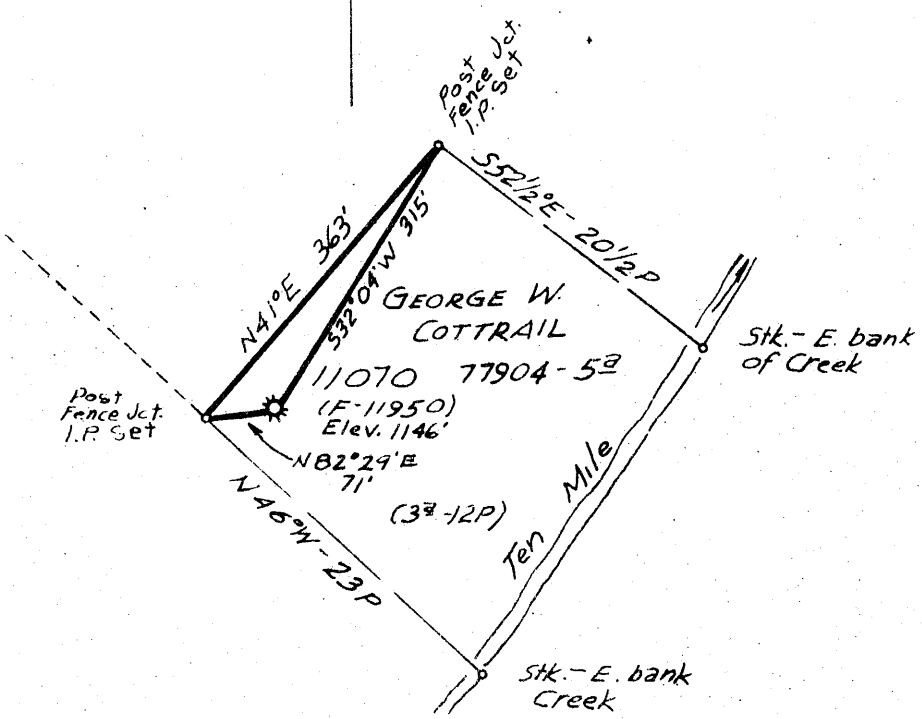

1.02S
3.85W

Minimum Error of Closure 1' IN 200'
 Source of Elevation B.M. - U.S.G.S. - W.S.M. 1957 - WEST MILFORD 7 1/2' TOPO MAP ELEVATION 1058'
 "I, the undersigned, hereby certify that this map is correct to the best of my knowledge and belief and shows all the information required by paragraph 6 of the rules and regulations of the oil and gas section of the mining laws of West Virginia."

- New Location
- Drill Deeper
- Abandonment

issued 10/26/72
MAP SHEET 55 S-15, E-7

F.B. 1625 Pgs 24-25

Company CONSOLIDATED GAS SUPPLY CORP.
 Address CLARKSBURG, W. VA.
 Farm GEORGE W. COTTRAIL
 Tract 5 Acres 5 Lease No. 77904
 Well (Farm) No. 11070 Serial No. 11070
 Elevation (Spirit Level) 1146'
 Quadrangle WESTON (N.W.)
 County HARRISON District UNION
 Engineer Jackson M. Lewis
 Engineer's Registration No. 2397
 File No. Drawing No.
 Date SEPTEMBER 13, 1972 Scale 1"=200'

STATE OF WEST VIRGINIA
 DEPARTMENT OF MINES
 OIL AND GAS DIVISION
 CHARLESTON

WELL LOCATION MAP
 FILE NO. Har-1096-A

+ Denotes location of well on United States Topographic Maps, scale 1 to 62,500, latitude and longitude lines being represented by border lines as shown.
 — Denotes one inch spaces on border line of original tracing.

STATE OF WEST VIRGINIA
DEPARTMENT OF MINES
OIL AND GAS WELLS DIVISION

RECEIVED
JUN 21 1973
OIL & GAS
DEPT. OF MINES

AFFIDAVIT OF PLUGGING AND FILLING WELL

AFFIDAVIT SHOULD BE MADE IN TRIPLICATE. ONE COPY MAILED TO THE DEPARTMENT, ONE COPY TO BE RETAINED BY THE WELL OPERATOR AND THE THIRD COPY (AND EXTRA COPIES IF REQUIRED) SHOULD BE MAILED TO EACH COAL OPERATOR AT THEIR RESPECTIVE ADDRESSES.

<p>Eastern Gas & Fuel Associates COAL OPERATOR OR OWNER <u>Rachel, W. Va.</u> ADDRESS</p> <hr/> <p>COAL OPERATOR OR OWNER <u>John Morris, Attorney</u> LEASE OR PROPERTY OWNER <u>Parkersburg, W. Va.</u> ADDRESS</p>	<p>Consolidated Gas Supply Corp. NAME OF WELL OPERATOR <u>Clarksburg, W. Va.</u> COMPLETE ADDRESS <u>June 13 1973</u> WELL AND LOCATION <u>Union</u> District <u>Harrison</u> County Well No. <u>11070</u> <u>George W. Cottrill</u> Farm</p>
--------------------------------------------------------------------------------------------------------------------------------------------------------------------------------------------------------------------------------------------------------------	------------------------------------------------------------------------------------------------------------------------------------------------------------------------------------------------------------------------------------------------------------------------------------------

STATE INSPECTOR SUPERVISING PLUGGING Mr. Wm. Blosser, Box 1857, Colfax, W. Va. Ph. 363-9105

AFFIDAVIT

STATE OF WEST VIRGINIA,
County of Monongalia } ss:

James Gump and Donnie Tennant

being first duly sworn according to law depose and say that they are experienced in the work of plugging and filling oil and gas wells and were employed by Chisler Brothers, well operator, and participated in the work of plugging and filling the above well, that said work was commenced on the 3rd day of April, 19 73, and that the well was plugged and filled in the following manner:

BAND OR ZONE RECORD	FILLING MATERIAL	PLUGS USED	CASING	
			CSG PULLED	CSG LEFT IN
FORMATION	TOTAL DEPTH <u>2,536'</u>	SIZE & KIND		
	<u>Gel 2,536-2,250'</u>	<u>3" tubing</u>	<u>2,250'</u>	<u>286'</u>
	<u>cement 2,250-2,210'</u>			
	<u>Gel 2,210-1,940'</u>			
	<u>Cement 1,940-1,900'</u>			
	<u>Gel 1,900-1,570'</u>			
	<u>Cement 1,570-1,550'</u>			
	<u>Gel 1,550- 530'</u>			
	<u>Cement 530- 510'</u>	<u>Cut 7" casing</u>	<u>530'</u>	<u>1,040'</u>
	<u>Gel 510- 176'</u>			
	<u>Cement 176- 120'</u>			
	<u>Gel 120- 10'</u>			
	<u>Cement 10'-Surface</u>			
COAL BEAMS		DESCRIPTION OF MONUMENT		
(NAME)		<u>Set 13' piece of 7" casing extending about 3' above the surface. Cemented inside and out with date and well Number as identification.</u>		
(NAME)				
(NAME)				
(NAME)				

and that the work of plugging and filling said well was completed on the 16th day of April, 19 73.

And further deponents saith not.

Sworn to and subscribed before me this 18th day of July, 19 73.

My commission expires:

June, 12 1976

James Gump
Donnie Tennant
Catherine J. Dwyer

Notary Public.

Permit No. Ham-1876-A