


P.P. + Red. 1012772 CEN

Latitude 39° 10'

Longitude 80° 20'

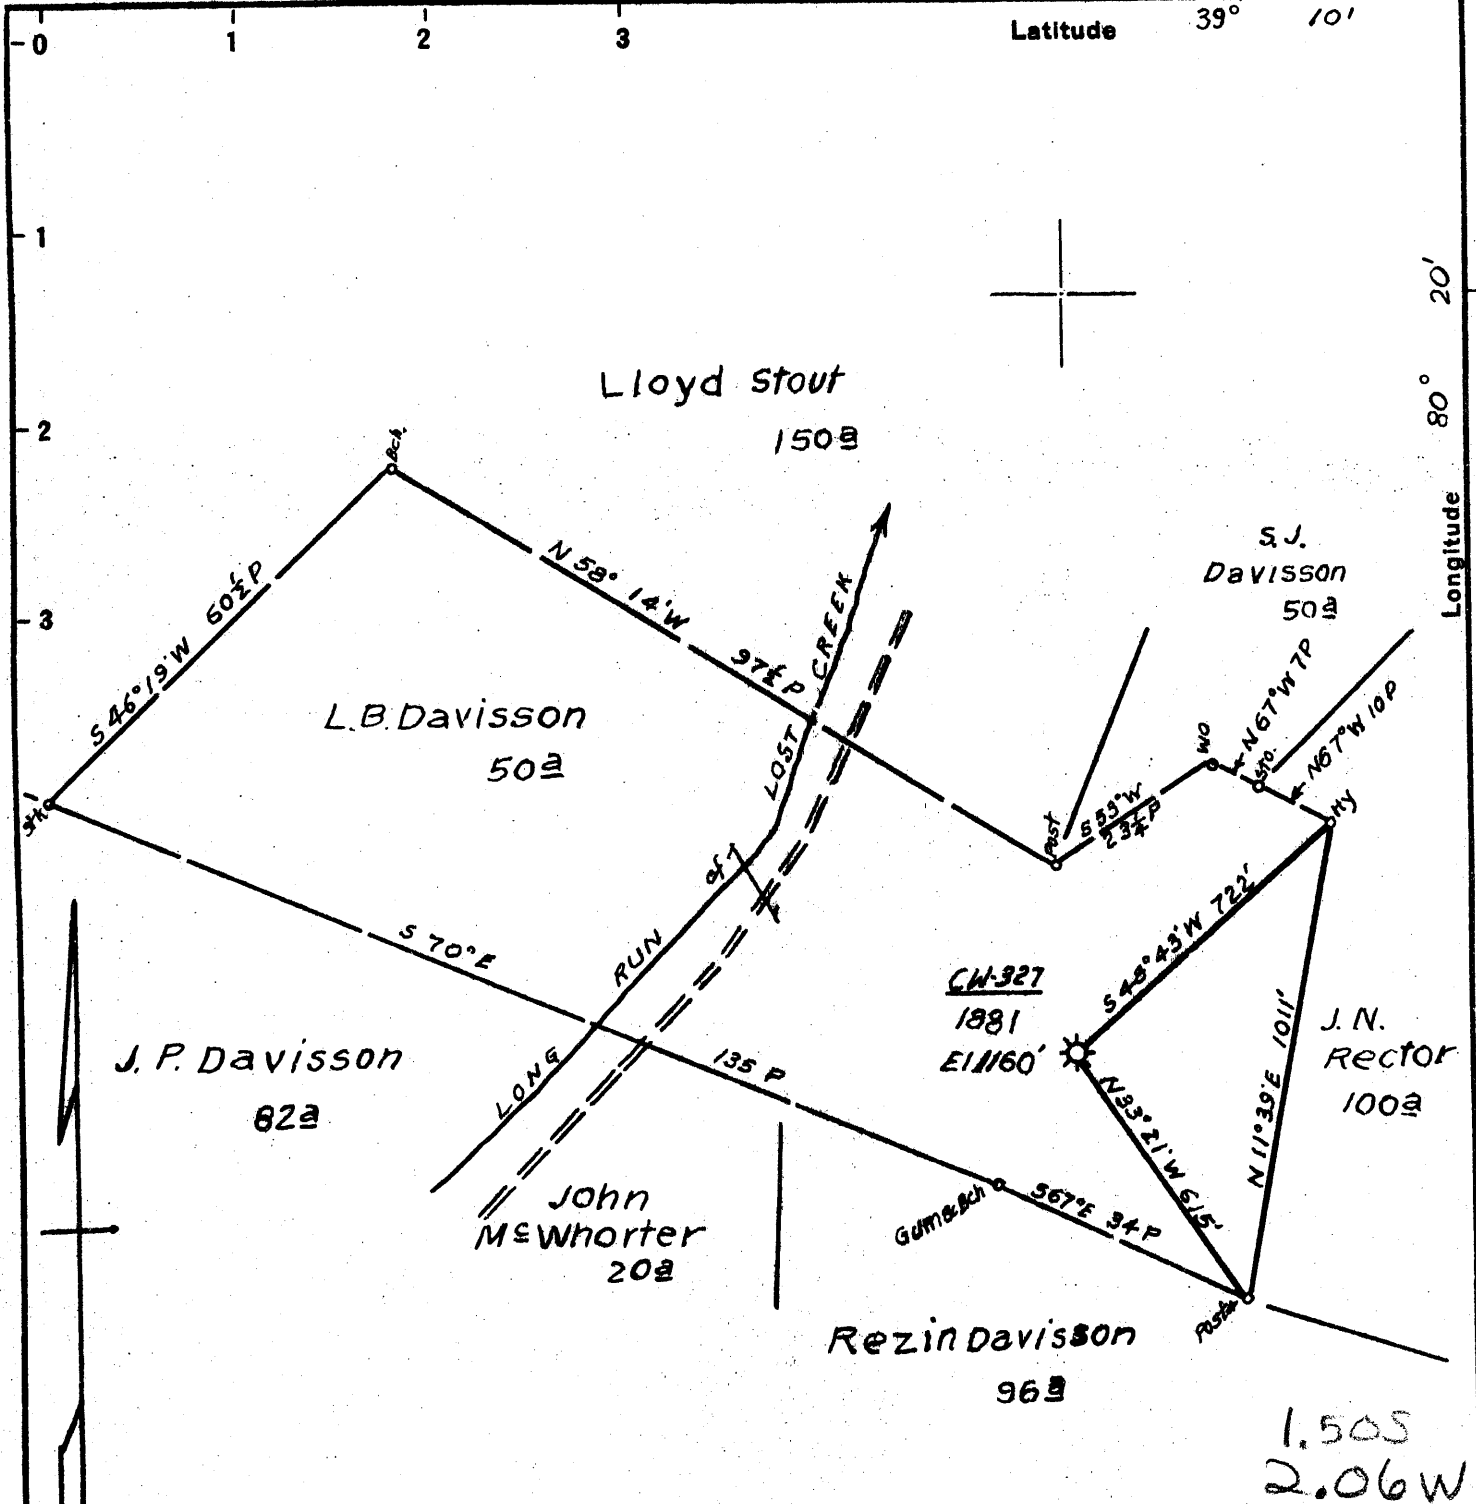

Minimum Error of Closure 1' IN 200'  
 Source of Elevation CONSOLIDATED GAS SUPPLY CORP  
WELL No. 327 El. 1160'  
 I, the undersigned, hereby certify that this map is correct to the best of my knowledge and belief and shows all the information required by paragraph 6 of the act and regulations of the oil and gas section of the mining laws of West Virginia.

REDRILL   
 New Location   
 Drill Deeper   
 Abandonment  - 11-21-72


MAP SH 56 S 22 E 13 FB 534 P 30

Company CONSOLIDATED GAS SUPPLY CORP  
 Address Clarksburg, W.Va.  
 Farm L.B. Davisson  
 Tract \_\_\_\_\_ Acres 50 Lease No. 21472  
 Well (Farm) No. \_\_\_\_\_ Serial No. 1881 CW-327  
 Elevation (Spirit Level) 1160'  
 Quadrangle Weston  
 County Harrison District Grant  
 Engineer Jackson M. Jarvis  
 Engineer's Registration No. 2397  
 File No. \_\_\_\_\_ Drawing No. \_\_\_\_\_  
 Date 10-20-72 Scale 1" = 400'

STATE OF WEST VIRGINIA  
 DEPARTMENT OF MINES  
 OIL AND GAS DIVISION  
 CHARLESTON

WELL LOCATION MAP  
 FILE NO. Har-1898-A-72

+ Denotes location of well on United States Topographic Maps, scale 1 to 62,500, latitude and longitude lines being represented by border lines as shown.  
 - Denotes one inch spaces on border line of original tracing.

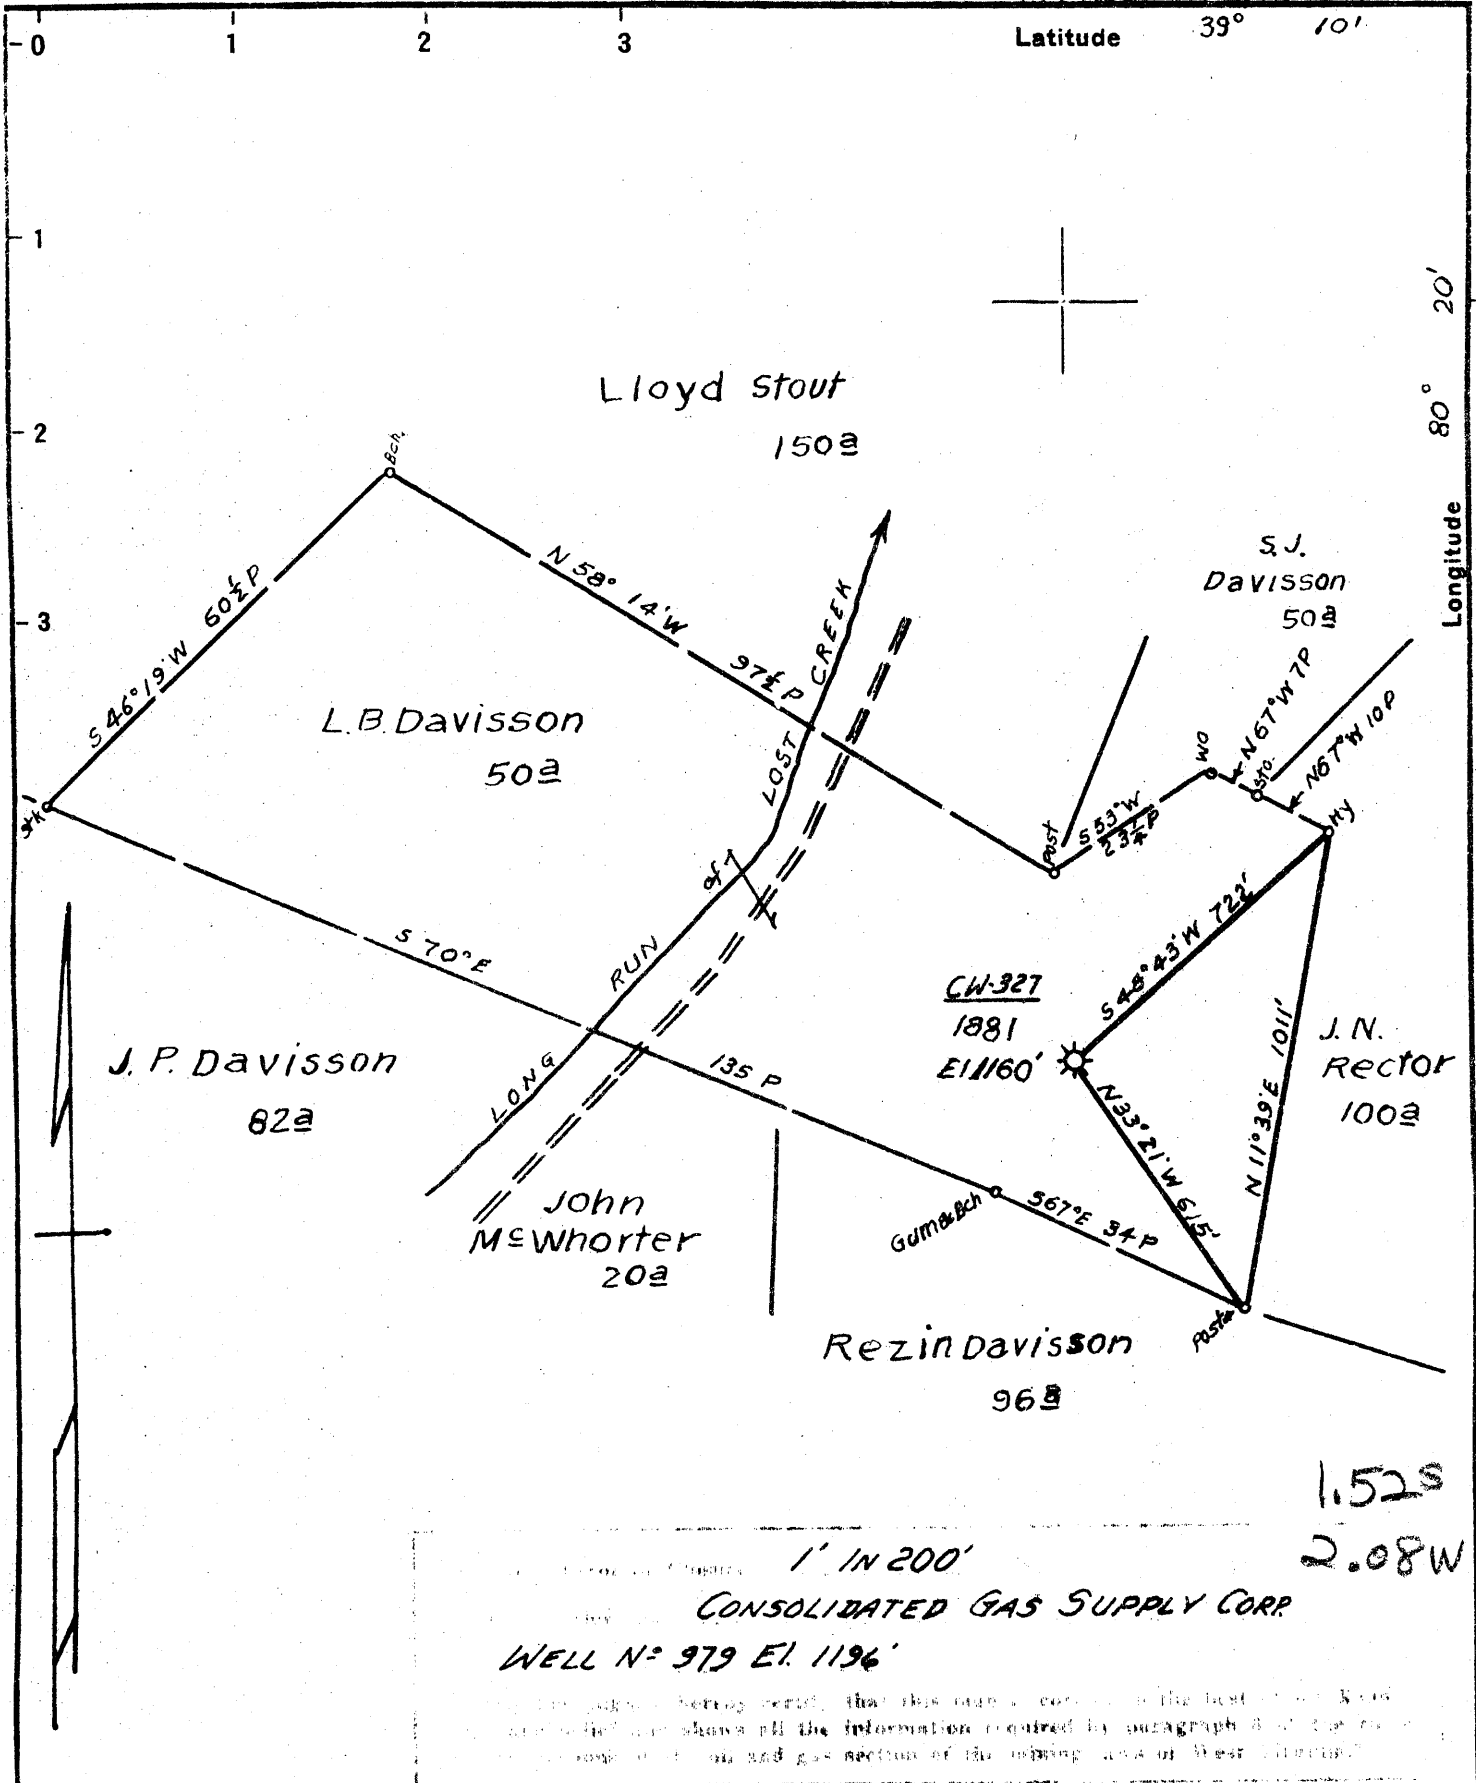

1' IN 200'  
 CONSOLIDATED GAS SUPPLY CORP.  
 WELL N° 979 El. 1196'

1.52S  
 2.08W

- REDRILL
- New Location
- Drill Deeper
- Abandonment

Map Sh 56 S 22 E 13 FB 534 P 30

Company CONSOLIDATED GAS SUPPLY CORP  
 Address Clarksburg, W.Va.  
 Farm L.B. Davisson  
 Tract \_\_\_\_\_ Acres 50 Lease No. 21472  
 Well (Farm) No. \_\_\_\_\_ Serial No. 1881 CW-327  
 Elevation (Spirit Level) 1160'  
 Quadrangle Weston C  
 County Harrison District Grant  
 Engineer Jackson M. Jarvis  
 Engineer's Registration No. 2397  
 File No. \_\_\_\_\_ Drawing No. \_\_\_\_\_  
 Date 10-20-72 Scale 1" = 400'

STATE OF WEST VIRGINIA  
 DEPARTMENT OF MINES  
 OIL AND GAS DIVISION  
 CHARLESTON

WELL LOCATION MAP  
 FILE NO. Har-1898-A-PP

+ Denotes location of well on United States Topographic Maps, scale 1 to 62,500, latitude and longitude lines being represented by border lines as shown.

- Denotes one inch spaces on border line of original tracing.