


1200'

LATITUDE 39° 10'

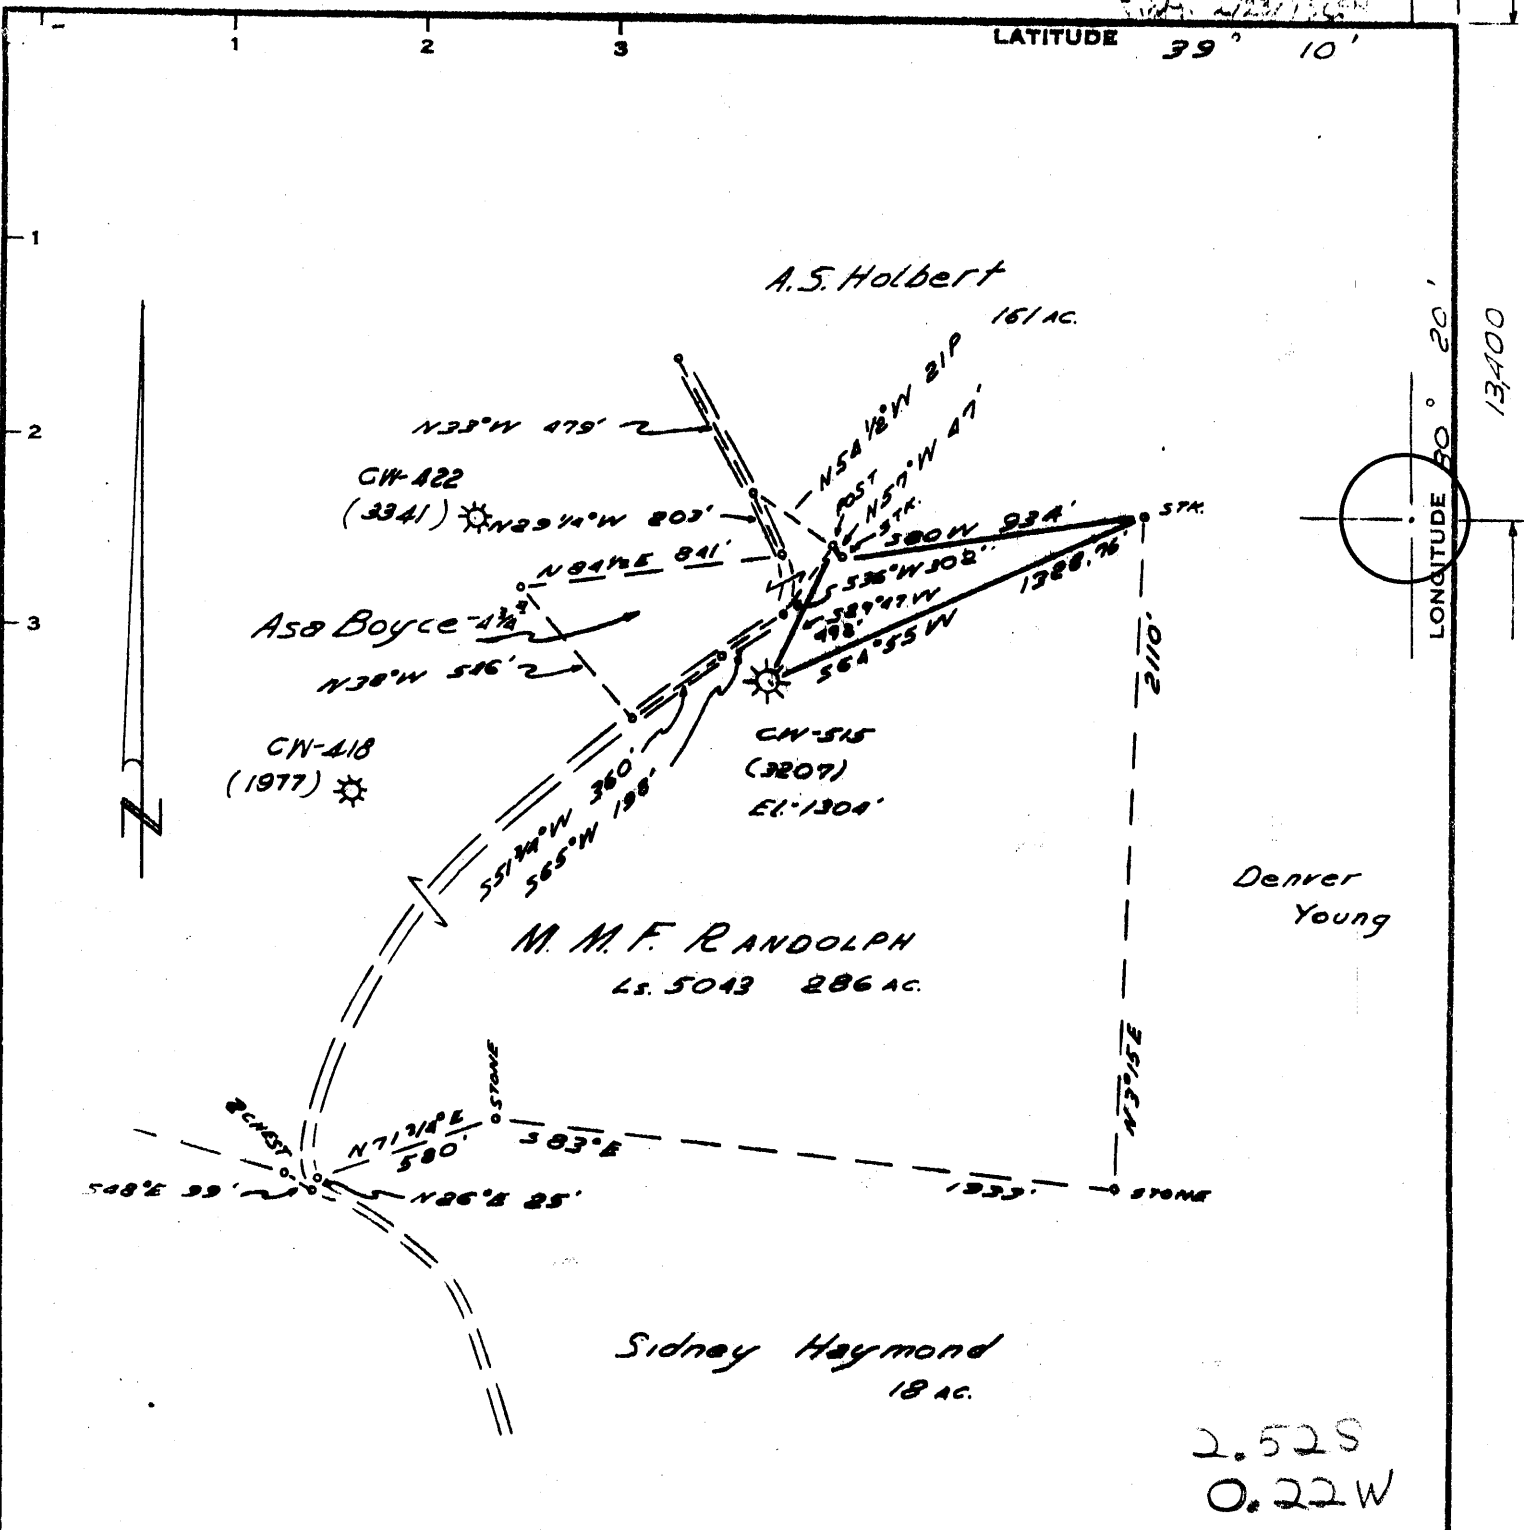

Denver Young

Sidney Haymond
18 AC.

2.52 S
0.22 W

Minimum Error of Closure 1" IN 200'
 Source of Elevation B.M. ON BRIDGE BY ROCKFORD ELEVATION
1059.86'
 "I, the undersigned, hereby certify that this map is correct to the best of my knowledge and belief and shows all the information required by paragraph 6 of the rules and regulations of the oil and gas section of the mining laws of West Virginia."

- New Location
- Drill Deeper
- Abandonment

issued 2/23/73
 MAP 51.56583616 FB.534 P-82-83

Company CONSOLIDATED GAS SUPPLY CORP.
 Address CLARKSBURG, WEST VA.
 Farm M.M.F. RANDOLPH
 Tract _____ Acres 286 Lease No. 5043
 Well (Farm) No. _____ Serial No. CW-515
 Elevation (Spirit Level) 1304'
 Quadrangle WESTON C
 County HARRISON District GRANT
 Engineer Jackson M. Jarvis
 Engineer's Registration No. 2397
 File No. _____ Drawing No. _____
 Date _____ Scale 1" = 600'

STATE OF WEST VIRGINIA
 DEPARTMENT OF MINES
 OIL AND GAS DIVISION
 CHARLESTON

WELL LOCATION MAP
 FILE NO. Har-1913 (A)

+ Denotes location of well on United States Topographic Maps, scale 1 to 62,500, latitude and longitude lines being represented by border lines as shown.
 - Denotes one inch spaces on border line of original tracing.



STATE OF WEST VIRGINIA
DEPARTMENT OF MINES
Oil and Gas Division
WELL RECORD

RECEIVED

FEB 5 1974

OIL & GAS DIVISION
DEPT. OF MINES

Quadrangle WESTON

Permit No. HAR-1913-A

Rotary XX Oil _____
Cable _____ Gas _____
Recycling _____ Comb. _____
Water Flood _____ Storage XX or none
Disposal _____ (Kind)

Company <u>Consolidated Gas Supply Corporation</u>	Casing and Tubing	Used in Drilling	Left in Well	Cement fill up Cu. ft. (Sks.)
Address <u>Clarksburg, W. Va.</u>				
Farm <u>M.M.F. Randolph</u> Acres <u>28 1/4</u>	Size			
Location (waters) <u>Lost Creek</u>	20-16			
Well No. <u>CW-515</u> Elev. <u>1304'</u>	Cond.			
District <u>Grant</u> County <u>Harrison</u>	13-10"			
The surface of tract is owned in fee by _____	9 5/8			
Address _____	8 5/8	928	565	
Mineral rights are owned by _____	7	1456	751	
Address _____	5 1/2	2162	None	
Drilling Commenced <u>10-3-73</u>	4 1/2			
Drilling Completed <u>10-6-73</u>	3	2360	None	
Initial open flow <u>OM</u> cu. ft. _____ bbls.	2			
Final production <u>None</u> cu. ft. per day _____ bbls.	Liners Used			
Well open <u>- -</u> hrs. before test <u>- -</u> RP.				

Well treatment details:
Not treated

Attach copy of cementing record.

Well redrilled and plugged to surface, not a storage well.
Located in Lost Creek Storage area.

Coal was encountered at None Feet _____ Inches _____
Fresh water None Feet _____ Salt Water None Feet _____
Producing Sand Well abandoned to surface Depth _____

Formation	Color	Hard or Soft	Top Feet	Bottom Feet	Oil, Gas or Water	* Remarks
THIS RECORD TAKEN FROM GAMMA RAY LOGGING						
Big Lime			1374	1439	No Gas	No Water
BIG INJUN			1439	1571	No Gas	
Gantz			1746	1782	Gas	1757-76' Show
Gantz A			1790	1826	No Gas	
Total Depth				2152'		

Consolidated Gas Supply Corporation
1415 West Main Street
Clarksburg, W. Va.

(over)

* Indicates Electric Log tops in the remarks section.