


Latitude 38° 40'

Longitude 81° 35'

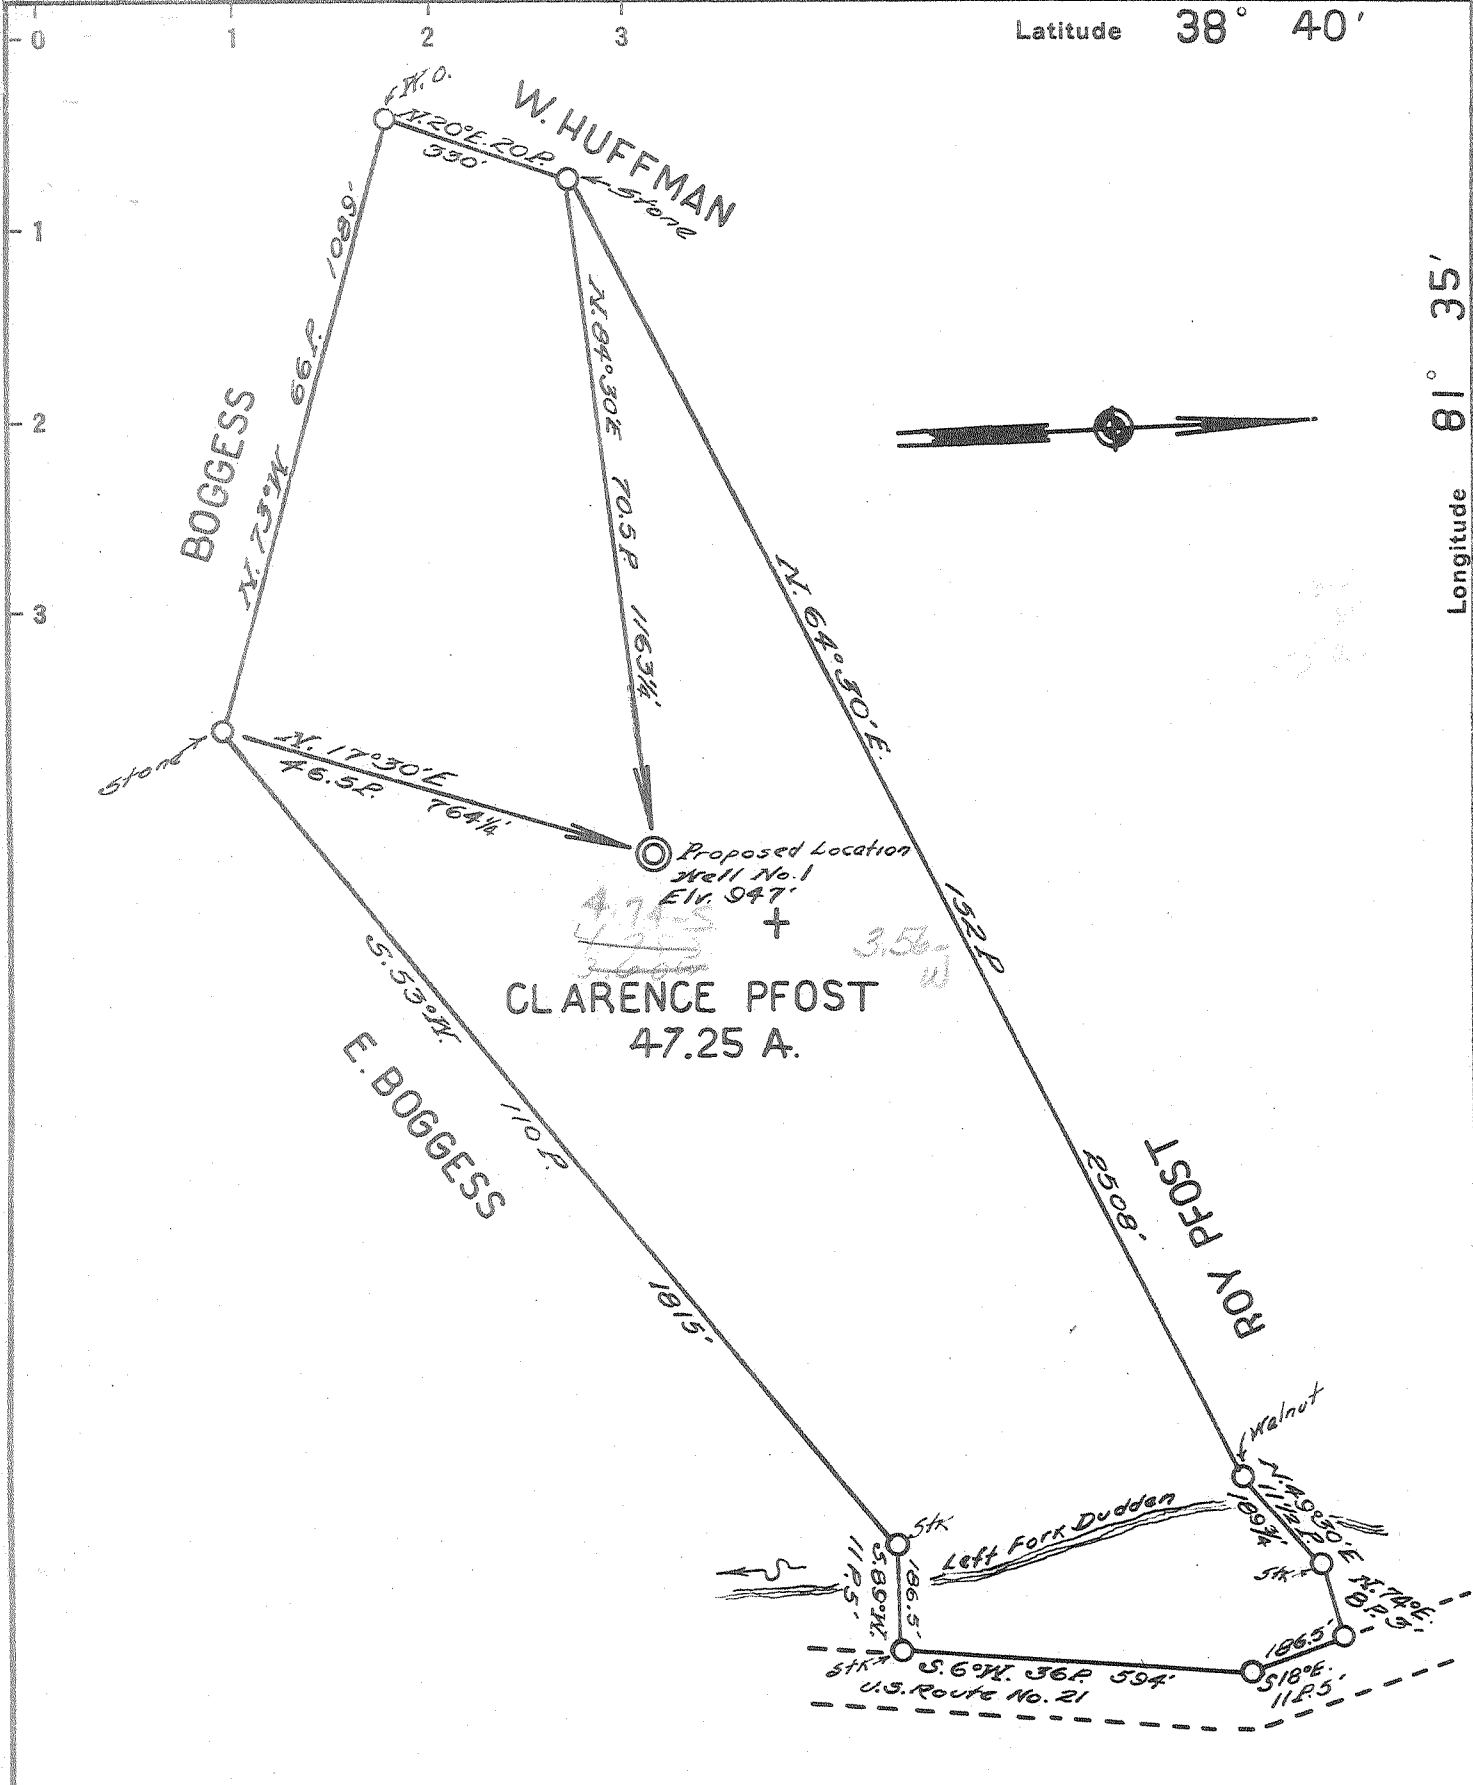

Proposed Location
Well No. 1
EIV. 947'
+
CLARENCE PFOST
47.25 A.

New Location
 Drill Deeper
 Abandonment 8-19-68

Company	JOE RUBIN		
Address	1900 19TH. ST. PARKERSBURG, W. VA.		
Farm	CLARENCE PFOST		
Tract	1	Acres	47.25
Lease No.			
Well (Farm) No.	1	Serial No.	
Elevation (Spirit Level)	947' 885 TOPO		
Quadrangle	KENNA		
County	JACKSON	District	RIPLEY
Engineer	J.E. ANDERSON		
Engineer's Registration No.	CO. SURVEYOR		
File No.		Drawing No.	
Date	FEB. 20 1940		
Scale	1 IN. = 20 POLES		

STATE OF WEST VIRGINIA
 DEPARTMENT OF MINES
 OIL AND GAS DIVISION
 CHARLESTON

WELL LOCATION MAP
 FILE NO. JAG-75-P

+ Denotes location of well on United States Topographic Maps, scale 1 to 62,500, latitude and longitude lines being represented by border lines as shown.

- Denotes one inch spaces on border line of original tracing.

6-6-68 Deep well

AUG 26 1968

WEST VIRGINIA DEPARTMENT OF MINES
OIL & GAS DIVISION
WELL RECORD

Permit No. ^{Ripley} Jac-75
Kenna Quad.

Gas Well

		CASING & TUBING		
Company	Joe Rubin, et al	18	28	28
Address	1900 - 19th St., Parkersburg, W. Va.	13-1/2	810	
Farm	Clarence Pfost ACRES -	7	2097	2097
Well No.	1 ELEV. - 881 700	5-3/16	5059	5059
District	Ripley - Jackson County			
Surface & Mineral	-			
Commenced	May 18, 1940			
Completed	August 14, 1940			
Shot	8/14/40 - Depth 5174			
Open Flow	- 8829 - Vol XVI			
Volume	-			
Rock Pressure	-			
Water	-			

Shot @ 5174 - Vol ~~XVI~~

Soil	0	28	
Red Shale	28	58	
Slate	58	98	
Shale	98	123	
Slate	123	153	
Red	153	188	
Slate&Shells	188	228	
Red Shale	228	273	3 bailers water at 899
Slate&Shells	273	323	
Shale	323	347	
Slate&Shells	347	410	
Red Rock	410	430	
Slate	430	470	
Red Rock	470	560	
Sand	560	575	
Blue Slate	575	600	
Red Rock	600	660	
Slate	660	730	
Sand	730	760	
Red Rock	760	805	
Sand	805	830	
Blue Slate	830	890	
Sand	890	935	Slight break
Sand	935	1045	
Blue Slate	1045	1100	
Sand	1100	1140	
Slate	1140	1145	
Sand	1145	1175	
Slate	1175	1200	
Sand	1200	1245	
Sandy Slate	1245	1335	
Slate - blue	1335	1450	
Sand & Some Shells	1450	1575	Water at 1580
Silt Sand	1575	1908	
Yame - ³⁰	1908	2014	
Slate	2014	2015	
Big Injun	2015	2060	
Sand & Shells	2060	2075	
Slate&Shells	2075	2460	
Black Slate - ^{up}	2460	2475	
Barca	2475	2490	
Slate&Shells	2490	3709	
Brown Shale - 441	3709	3755	
Gray Shale	3755	4138	
Brown Shale	4138	4230	
Slate	4230	4740	
Brown Shale	4740	4960	
Black Shale - ^{Marshall}	4960	5016	
Sime - 463	5035	5141	SLM
Triskany	5141	5174	
Sime	5174	5179	
Bottom	5179		

480