


P

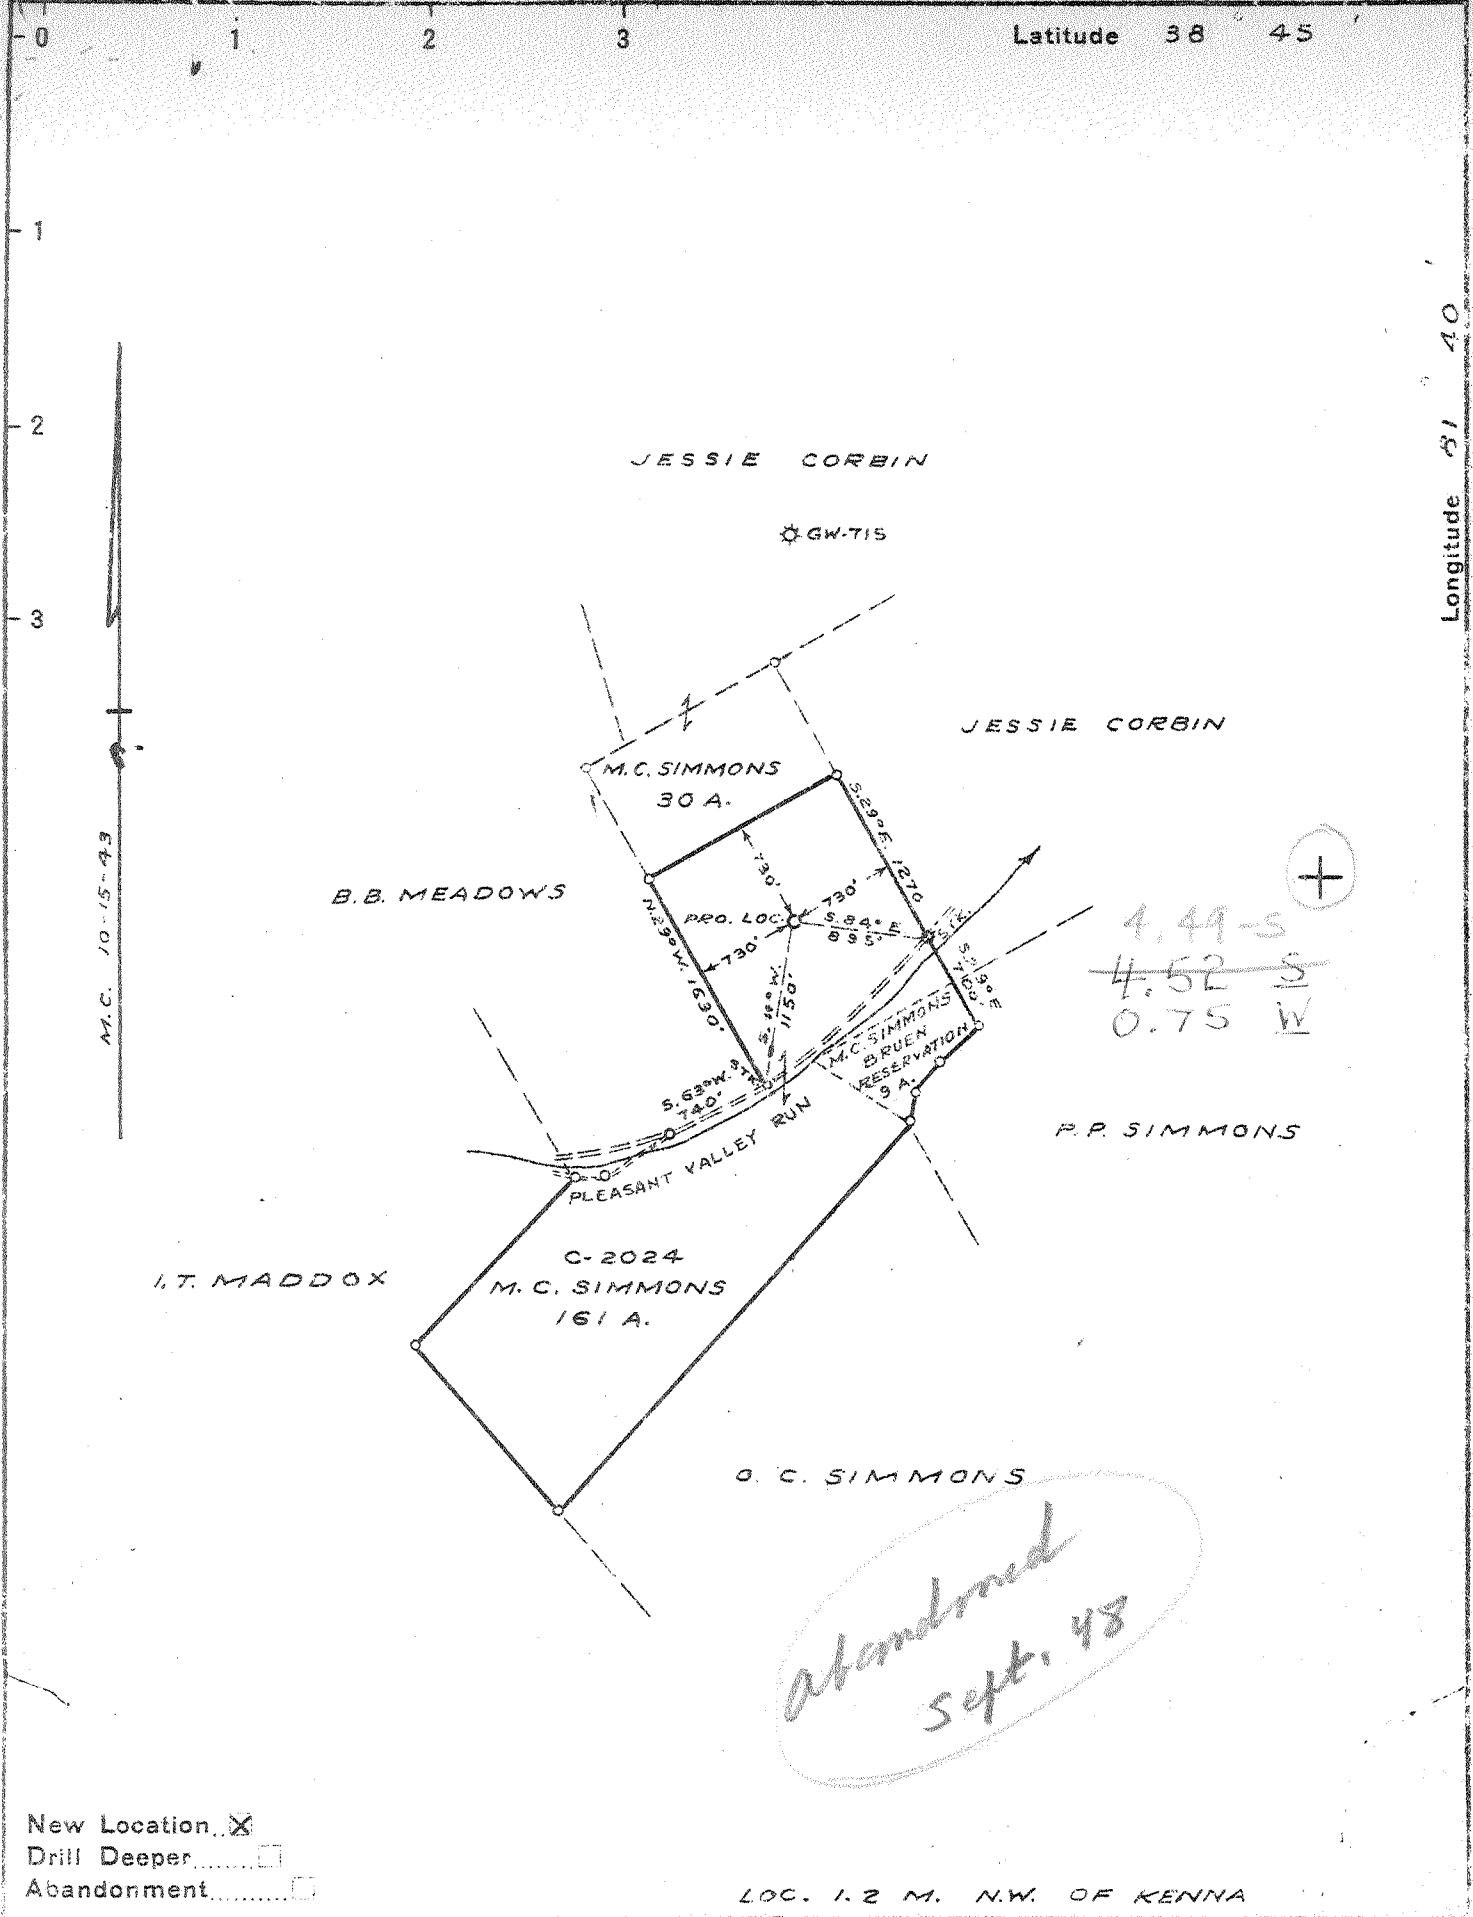

New Location
 Drill Deeper
 Abandonment

LOC. 1.2 M. N.W. OF KENNA

Company COLUMBIAN CARBON CO.
 Address BOX 873 CHARLESTON W.VA.
 Farm M. C. SIMMONS
 Tract _____ Acres 161 Lease No. C-2024
 Well (Farm) No. 1 Serial No. _____
 Elevation (Spirit Level) 828.6
 Quadrangle KENNA N.W. 3
 County JACKSON District RIPLEY
 Engineer [Signature]
 Engineer's Registration No. 772
 File No. _____ Drawing No. 235
 Date OCT. 26, 1943 Scale 1" = 1320'

STATE OF WEST VIRGINIA
 DEPARTMENT OF MINES
 OIL AND GAS DIVISION
 CHARLESTON

WELL LOCATION MAP
 FILE NO. J.A.C. - 465

+ Denotes location of well on United States Topographic Maps, scale 1 to 62,500, latitude and longitude lines being represented by border lines as shown.
 - Denotes one inch spaces on border line of original tracing.

6-6-48

Deep Well

WEST VIRGINIA DEPARTMENT OF MINES
OIL & GAS DIVISION
W E L L R E C O R D

Gas Well
CASING & TUBING

Permit No. Jac 465	
Kenna N.W. Quad.	
Company	Columbian Carbon Company
Address	Box 873, Charleston, 23, W.Va. 16(62.30)78'10 Same
Farm	M.C. Simmons Acres 161 13 3/8(48) 729'10 None
Location	Pleasant Valley Run 10 1/2(35.75) 1163'1 "
Well No	1 (GW-730) Elev. 832.1 DF 8 1/2(24#) 2130'9 "
District	Ripley Jackson County 6 5/8(24#)5038' Same
Surface	M.C. Simmons, Fairplain, W.Va. 2 3/8(4#)5139'6 Same
Mineral	M.C. Simmons, Fairplain, W.Va. 3 1/2(8.7#) 74'9 Same
Commenced	11-29-43
Completed	3-15-44
Date shot	3-15-44 Depth 5093 SLM to 5133 SLM with 266-2/3# Gelatin
Volume	365 MCF
Rock Pressure	1600 lbs. 16 hrs.
Salt Water	1085' 1/2-13" Blr.; 1700' H.F.

No Packer
No coal

Red Rock	0	55	Slate & Shells	2104	2110
Sand	55	70	Lime Shells	2110	2120
Red Rock	70	95	Slate & Shells	2120	2478
Lime	95	120	Lime	2478	2525
Red Rock	120	140	Slate & Shells	2525	3980
Lime	140	160	Brown Slate - 441	3980	4060
Blue Slate	160	180	Slate & Shells	4060	4090
Red Rock	180	190	White Slate	4090	4169
Slate & Shells	190	203	Brown Slate	4169	4320
Sand	203	240	White Slate	4320	4720
Red Rock	240	260	Brown Slate	4720	4985SL
Sand	260	275	Corniferous Lime - 463 SLM	4985	5093
Red Rock	275	390	Oriskany Sand SLM	5093	5136
Lime	390	398	Lime } HELD.	5136	5142
Red Rock	398	471	Sand	5142	5148
Slate & Shells	471	510	TOTAL DEPTH	SLM	5148
Red Rock	510	535			
Blue Slate	535	580			
Red Rock	580	595			
Slate & Shells	595	613			
Red Rock	613	680			
Sand	680	705			
Red Rock	705	727	SLM		
Lime	727	741			
Slate & Shells	741	746			
Red Rock	746	795			
Lime	795	828			
Slate & Shells	828	840			
Lime	840	860			
White Slate	860	865			
Sand	865	885			
Slate & Shells	885	914			
Red Rock	914	922			
Slate & Shells	922	990			
Red Rock	990	995			
Lime	995	1025			
Sand	1025	1052			
Slate	1052	1060			
Sand - Big Discard?	1060	1137			
Slate & Shells	1137	1260			
Sand	1260	1290			
Slate & Shells	1290	1388			
Sand	1388	1425			
Slate & Shells	1425	1628			
Sand - Salt Sand?	1628	1938			
Shale	1938	1940			
Lime - Big Ling?	1940	1964			
Sand - Injun?	1964	2097			
Shale	2097	2104			

4985 5093
832 832
4153 4261

All Columbian Carbon Company Crew.